



Map No. Kan Sec. 12 Twp. 22 R. 10

Well No. 4 Warrensburg Farm  
Phillips Pet Company


\_\_\_\_\_ Ft. from N. Line

990 Ft. from S. Line

990 Ft. from E. Line

\_\_\_\_\_ Ft. from W. Line

*C*

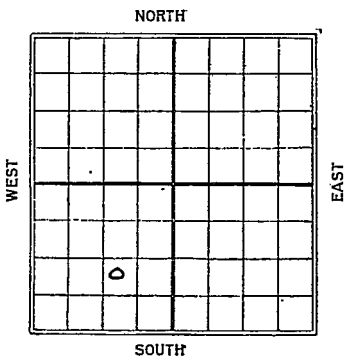

Date	REPORT
1925	
7/3	Location
7/10	_____
7/17	Rig
7/24	_____
7/31	Rigging up
8/7	_____
8/14	_____
8/19	_____
8/26	1500
9/3	Abandoned 2348

Map No. 21 Range Sec. 12 Twp. 22 R. 10

Well No. 4 Walter Shurg  
Phillips Pet & Co Company

Contractor

FIRST REPORTS

SECTION PLAT

----- Ft. from N. Line

990 Ft. from S. Line

996 Ft. from E. Line

----- Ft. from W. Line

	o		

Location  -----

Rig up -----

Drilling and Remarks: -----

RECORD

Cased \_\_\_\_\_ in., \_\_\_\_\_ ft.

Sand -----

Gas -----

Oil -----

Total Depth -----

PRODUCTION

1st 24 hrs. Nat. -----

1st 24 hrs. after shot -----

Gas ----- Cu. Ft.

Dry Hole -----

Abandoned -----

Date

JUL 3 1925

CHAS. L. SHERWOOD

*Storwood Co*

Map No. *21* KANSAS Sec. *12* Twp. *22* R. *10*

Well No. *4* *Wartensburg*

*Phillips Petroleum Co* Company

Contractor

COMPLETED

SECTION PLAT

Ft. from N. Line

*990*

Ft. from S. Line

*990*

Ft. from E. Line

Ft. from W. Line

ABANDONED

	<i>0</i>		

Location -----

Rig up -----

Drilling and Remarks:

*Shot 2157-80'*  
*Black shal 2180-*  
*2235'*  
*T.D. 2248'*  
*Dry & lhd*

RECORD

Cased ----- in., ----- ft.

Sand -----

Gas -----

Oil -----

Total Depth *2348'*

PRODUCTION

1st 24 hrs: Nat. -----

1st 24 hrs. after shot -----

Gas ----- Cu. Ft.

Dry Hole

Abandoned

Date

SEP 3 1925

CHAS. L. SHERWOOD

192 Scout