


12-22-10E

10" 1232 FARM S. K. Warrensburg NO. 4 COUNTY Greenwood.  
 20" 8 1-4 1849 COMPANY Phillips Petroleum Co.  
 15 1-2 6 5-8 2136 CONTRACTOR John W. Davisson.  
 12 1-2 6 2 5 3-16 COMMENCED Aug 3, 1925 COMPLETED Aug 24, 1925  
 TOTAL DEPTH 2348 SHOT QUARTS BETWEEN

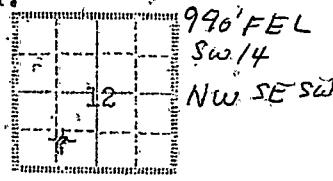

COF RESPONDENCE REGARDING THIS WELL SHOULD BE REFERRED TO Phillips Petroleum Co.  
 Bartlesville, Okla. ELEVATION 1266 0 Gr.  
 FIGURES INDICATE BOTTOM OF FORMATIONS. INITIAL PRODUCTION Dry Hole.  
 REMARKS

Formation	Depth	Formation	Depth.
soil black soft	5	slate white soft	1070
lime white hard	15	lime light hard	1080
mud black soft	25	slate white soft	1112
slate light soft	140	sand white soft	1180 HFW 1130
slate dark soft	185	lime white hard	1195
lime white hard	200	slate dark soft	1200
slate white soft	230	sand white hard	1218
lime white hard	240	slate dark soft	1223 10"1234
slate light soft	245	lime white hard	1255
lime white hard	251	slate dark soft	1260
slate white soft	280	lime white hard	1340
lime white hard	290	slate white soft	1415
slate white soft	310	lime white hard	1425
slate dark soft	320	shale blue soft	1460
slate white soft	372	lime white hard	1640
lime white hard	375	shale blue soft	1675
slate white soft	435	shale white soft	1745
lime white hard	470	lime white hard	1755
slate white soft	520	slate white soft	1770 8 1/2 1769 U/R 1848
lime white hard	575	lime white hard	1775
slate white soft	595	shale white soft	1785
lime white hard	600	lime white hard	1800
sandy shale light soft	605	lime white soft	1820 3BW Per Hr.
lime light hard	640	slate white soft	1855
12 1/2	628	lime white hard	1905
slate white soft	645	shale blue soft	1915
lime white hard	650	lime white hard	1925
slate white soft	665	slate white soft	1975
slate dark soft	685	shale dark soft	2010
lime white hard	695	lime white hard	2020
slate white soft	700	shale blue soft	2035
lime light hard	710	lime white hard	2055
slate white soft	715	slate black soft	2060
lime white hard	730	lime dark hard	2065
slate white soft	755	shale grey soft	2080
lime white hard	765	slate white soft	2130 6-5/8 2136
slate white soft	820	slate black soft	2140
lime white hard	830	shale black soft	2157
slate white soft	842	sandy shale black soft	2181
lime white hard	875	shale black soft	2238
slate dark soft	880	slate white soft	2245
slate white soft	885	sand white hard	2251
lime white hard	910	lime white hard	2294
slate white soft	925	lime brown hard	2340
lime white hard	930	lime brown soft	2348
slate white soft	950	HFW	2348 T.D.
lime light soft			