


Map No. Kansas Sec. 12 Twp. 22 R. 11 ✓

Well No. 2 Bush Farm

Empire G. & F. Company

NORTH

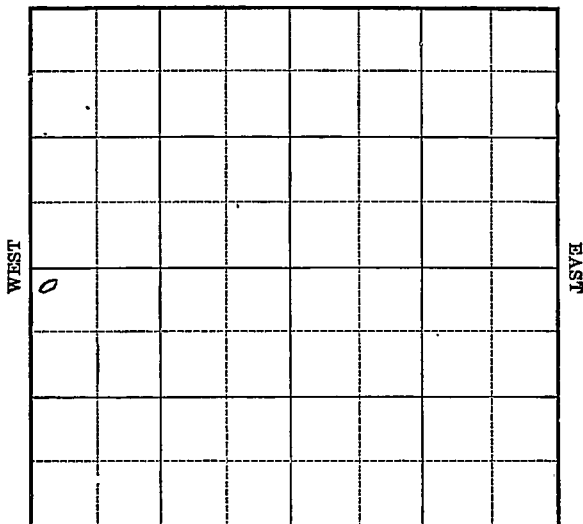

SOUTH

12

Location _____

Drilling Remarks

Rig Up _____

Drilling Remarks

RECORD

Cased _____ in. _____ ft.

Sand _____

Gas _____

Oil _____

Total Depth _____

PRODUCTION

1st 24 hrs. Nat. _____

1st. 24 hrs. after shot _____

Gas _____ cu. ft.

Dry Hole _____

Abandoned _____

Map No. Kansas Sec. 12 Twp. 22 R. 11

Well No. 2 Bush Farm


Empire Gas & Fuel Company

330 Ft. from N. Line

..... Ft. from S. Line

..... Ft. from E. Line

330 Ft. from W. Line

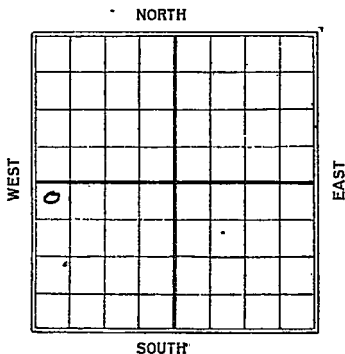

Date
1925

REPORT

5/12 Timbers

6/18 Sand 1772-1819 P.B.
to 1813 40 gts 75 Bbls

Map No. 1744 Sec. 12 Twp. 22 R. 11

Well No. 2 Bush

Empire Oil & Fuel Company

Contractor

FIRST REPORTS

SECTION PLAT

230 Ft. from N. Line

_____ Ft. from S. Line

_____ Ft. from E. Line

330 Ft. from W. Line

0			

Location _____

Rig up Ambers.

Drilling and Remarks:

RECORD

Cased _____ in., _____ ft.

Sand _____

Gas _____

Oil _____

Total Depth _____

PRODUCTION

1st 24 hrs. Nat. _____

1st 24 hrs. after shot _____

Gas _____ Cu. Ft.

Dry Hole _____

Abandoned _____

Date

MAY 21 1925

192

CHAS. L. SHERWOOD

Scout

Map No. 27 1/2 Sec. 13 Twp. 22 R. 11

Well No. 2 Bush

Empire Oil & Fuel Co Company

Contractor

COMPLETED

SECTION PLAT

230 Ft. from N. Line

_____ Ft. from S. Line

_____ Ft. from E. Line

230 Ft. from W. Line

0			

Location _____

Rig up _____

Drilling and Remarks:

Plugged back
To 1813'

40
75 b/s

RECORD

Cased _____ in., _____ ft.
Sand 1772-1819
Gas _____
Oil _____
Total Depth 1819

PRODUCTION

1st 24 hrs. Nat. _____
1st 24 hrs. after shot _____
Gas _____ Cu. Ft.
Dry Hole _____
Abandoned _____

Date

JUN 18 1925

CHAS. L. SHERWOOD

192

Scout