


Map No. Kansas Sec. 12 Twp. 22 R. 11 ✓

Well No. 3 Mc Librey Farm

Fisher-Louck & White Eagle Company

NORTH

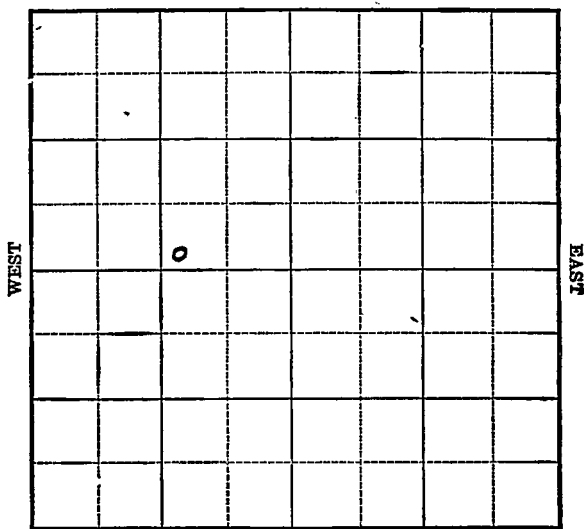

SOUTH

6

Location _____

Rig Up _____

Drilling Remarks:

Drilling Remarks:

RECORD

PRODUCTION

Cased _____ in. _____ ft.

1st 24 hrs. Nat. _____

Sand _____

1st 24 hrs. after shot _____

Gas _____

Gas _____ cu. ft.

Oil _____

Dry Hole _____

Total Depth _____

Abandoned _____

Map No. 21 Kndn Sec. 12 Twp. 22 R. 11

Well No. 3 Mc Pelley
Fisher-Lucas & White Co. Contractor

FIRST REPORTS

SECTION PLAT

----- Ft. from N. Line

330 Ft. from S. Line

990 Ft. from E. Line

----- Ft. from W. Line

	o		

Location -----

Rig on ground

Drilling and Remarks:

RECORD

Cased ----- in., ----- ft.

Sand -----

Gas -----

Oil -----

Total Depth -----

PRODUCTION

1st 24 hrs. Nat. -----

1st 24 hrs. after shot -----

Gas ----- Cu. Ft.

Dry Hole -----

Abandoned -----

Date

APR 17 1925

192

Chas. L. Sheward Scout

Map No. 14nd Sec. 12 Twp. 22 R. 11

Well No. 3 Ac Delloy
Fisher, Leucis & White Eagle Company

Contractor

COMPLETED

SECTION PLAT

_____ Ft. from N. Line

330

_____ Ft. from S. Line

990

_____ Ft. from E. Line

_____ Ft. from W. Line

	o		

Location _____

Rig up _____

Drilling and Remarks:

1401
200 bls

RECORD

Cased _____ in., 6 1/2 ft.

Sand 1793-1828

Gas _____

Oil _____

Total Depth 1828

PRODUCTION

1st 24 hrs. Nat. _____

1st 24 hrs. after shot _____

Gas _____ Cu. Ft.

Dry Hole _____

Abandoned _____

Date

MAY 29 1925

192

CHAS. L. SHERWOOD
 Scout