

WELL LOG BUREAU--KANSAS GEOLOGICAL SOCIETY
508 East Murdock,
Wichita, Kansas


34-22-13E

Company- HUFF & FISEMEYER
Farm- Esslinger No. 12

SEC. 34 T. 22 R. 13E
CN $\frac{1}{2}$ NE SW

Total Depth. 1867 $\frac{1}{2}$
Comm. 11-20-49 Comp. 12-14-49
Shot or Treated.
Contractor. White & Ellis Drlg. Co.
Issued. 12-8-51

County Greenwood
KANSAS

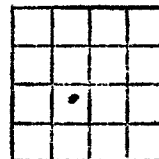

CASING:

10" OD 65'
7" OD 1860'

Elevation. _____

Production. phy. 15 bbls.

Figures Indicate Bottom of Formations.


gravel	5
shale	40
lime, shells, shale	125
lime	151
shale, shells	380
lime	390
shale	405
lime	430
shale, shells	600
lime	620
shale, shells	700
lime	855
shale	870
lime	990
shale	1100
lime	1150
shale	1160
lime	1175
shale	1227
lime	1245
shale	1300
lime	1337
shale	1341
lime	1370
shale, shells	1418
lime	1425
shale, shells	1620
sandy shale	1625
shale, lime, shells	1699
shale	1838
lime, top of Miss.	1856
lime, brown, hard	
no oil stain or odor	
	1859 $\frac{1}{2}$
lime, grown, softer	
slight oil stain,	
slight odor	1860
Cable tools:	
lime, brown some	
oil	1861
sandy lime, soft, oil	
saturated	1867 $\frac{1}{2}$
Total depth	

Tops:
Mississippi 1856

Greenwood **KANSAS**Section 34 Township 22 Range 13EWell No. #12 EsslingerCompany G. Huff

Miscellaneous

NORTH

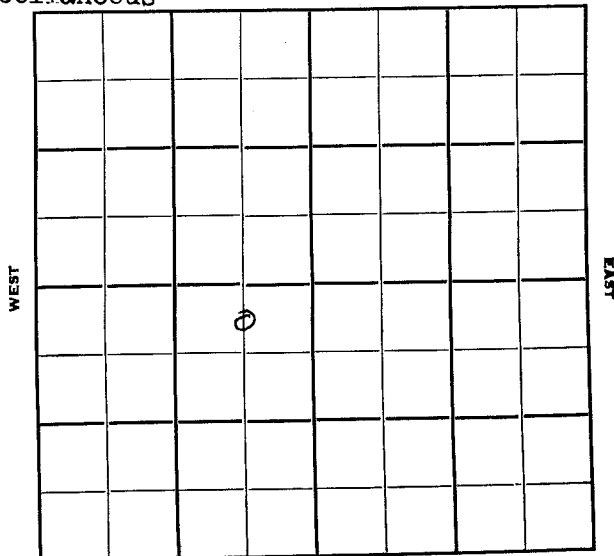

SOUTH

KANSASSec. 34 Twp. 22 R. 13EWell No. #12 Esslinger Farm


G. Huff

Company

Miscellaneous (White & Ellis Contr.)

330' Ft. from N. Line Ft. from S. Line660' Ft. from E. Line Ft. from W. Line

G N L NE SW

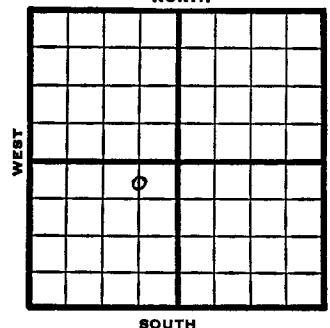

1949

REPORT

11/30 Surface Hole
 12/7 Miss 1838'
 TD 1860'
 7" @ 1860'
 12/14 TD 1865 - 2000 acid
 12/21 TD 1865'
 Miss 1838'
 7" @ 1860'
 2000 acid
 Pump 15 0.1 Pot
 38° Gr.
 Comp

COMPLETED

Form 26 200 Bks. 6-49 Petrol
Kansas

Miscellaneous

Map No. _____ Sec. 34 Twp. 22 R. 13E

Well No. 12 Esslinger

G. Huff Company

White & Ellis Contractor

C N L NE SW

FIRST REPORT
SECTION PLAT

330 Ft. from N. Line

_____ Ft. from S. Line

660 Ft. from E. Line

_____ Ft. from W. Line

Greenwood County

Location _____

Rig up _____

Drilling and Remarks:

surface hole

RECORD
Cased _____ in., _____ ft.
Sand _____
Gas _____
Oil _____
Total Depth _____

PRODUCTION
1st 24 hrs. Nat. _____
1st 24 hrs. after shot _____
Gas _____ Cu. Ft.
Dry Hole _____
Abandoned _____

Date

NOV 30 1949

19

S. J. LEWIS

Scout

Form 26 200 Bks. 6-49 Petrol
Kansas

Miscellaneous

Map No. _____ Sec. 34 Twp. 22 R. 13E

Well No. 12 Esslinger

G. Huff Company

C N L NE SW **COMPLETE** Contractor

SECTION PLAT

330 Ft. from N. Line

_____ Ft. from S. Line

660 Ft. from E. Line

_____ Ft. from W. Line

Greenwood County

Location _____

Rig up _____

Drilling and Remarks:

Blas 1838

7" @ 1860

20000000

Pump Bail

3524

Date

DEC 21 1949

19

S. J. LEWIS

Scout