

RETURN TO GULF OIL CORP.


WELL LOG BUREAU - KANSAS GEOLOGICAL SOCIETY
412 Union National Bk. Bldg., Wichita, Kansas

Company - C. A. AIKMAN AND SONS & W. F. BRADEN
Farm - Koenig No. 3
Koenig

SEC. 27 T. 22 R. 13E
NW SE SW

Total Depth. 1897
Comm. 6-10-46 Comp. 7-13-46
Shot or Treated. Shot w/40 quarts.
Contractor. Braden Drilling Co.
Issued. 5-7-49

County. Greenwood
KANSAS

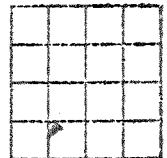

CASING:
10" 750' P 6 5/8" 1872 LI cem w/15 sx.
8" 1188' P


Elevation. _____

Production. Est. 5 bbls.

Figures Indicate Bottom of Formations.

soil	1	lime	1045
clay	60	red bed	1047
shale	95	shale	1072
lime	110	lime	1145
shale	120	shale	1148
lime	125	lime	1181
shale	133	shale	1187
lime	140	lime	1193
shale	145	shale	1196
lime	150	lime	1212
shale	175	shale	1344
lime	185	lime	1350
shale	190	shale	1367
redrock	205	lime	1377
shale	210	shells	1402
lime	215	lime	1408
shale	225	shale	1430
lime	235	lime	1434
shale	250	shale	1450
lime	260	lime	1460
shale	265	shale	1485
lime	275	lime shells	1544
shale	315	lime	1549
lime	320	shale	1555
shale	335	sand	1570
lime	338	shale	1600
shale	360	lime	1603
lime	365	shale	1675
shale	370	B. shale	1685
lime	375	shale	1705
shale	405	red rock	1715
lime	412	shale	1730
shale	435	shells	1860
lime	452	chat	1870
shale	472	lime	1890
lime	487	Pay Lime ?	1897
shale	530	Total depth	
lime	535	Water Record:	
shale	685	HFw 725	
lime	690	HFw 995	
sand	698	1/2 BW 1402	
shale	709		
lime	715		
sand	732		
shale	772		
lime	776		
shale	783		
lime	800		
shale	805		
lime	815		
shale	820		
lime	867		
shale	875		
lime	990		
limeSft	1005		
lime	1033		
shale	1038		


Section 27 Township 22 Range 13E
Well No. #3 Koenige Koenig
Company Aikman & Braden

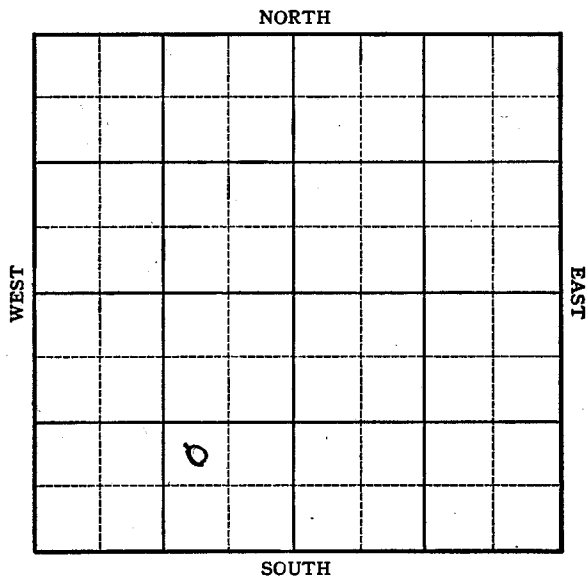

Sec. 27 Twp. 22 R. 13-E
Well No. #3 Koenige Koenig Farm
Aikman & Braden Company

Miscellaneous

_____ Ft. from N. Line
990 Ft. from S. Line
990 Ft. from E. Line
_____ Ft. from W. Line

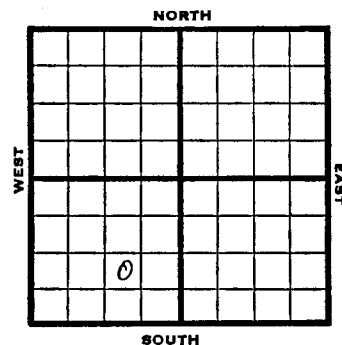

NW SE SW

1946	REPORT
6/19	10" @ 750' Drlg 825'
6/26	8" @ 1188' Drlg 1215'
7/3	Miss 1870 6" @ 1872' Drlg 1886'
7/9	TD 1897 40 qts 1888-97 CO
8/17	Miss. 1870 6" @ 1872 TD 1897 40 qts. 1500 acid. Pump 4 Pot. Grav. 38.0

COMPLETED

KANSAS Kansas Pool Name Miscellaneous
 Map No. 21 Sec. 27 Twp. 22 R. 13E
 Well No. 3 Koenige Koenig

Aikman & Braden Company

FIRST REPORT Contractor

NW SE SW

SECTION PLAT

 Ft. from N. Line
990 Ft. from S. Line
990 Ft. from E. Line
 Ft. from W. Line

Greenwood County

Location _____
 Rig up _____
 Drilling and Remarks:

10" @ 750'

825'

RECORD

Cased _____ in., _____ ft.
 Sand _____
 Gas _____
 Oil _____
 Total Depth _____

PRODUCTION

1st 24 hrs. Nat. _____
 1st 24 hrs. after shot _____
 Gas _____ Cu. Ft.
 Dry Hole _____
 Abandoned _____

Date

JUN 19 1946 19 S. J. LEWIS Scout

20 Kansas Pool Name Miscellaneous
 Map No. 20 Sec. 27 Twp. 22 R. 13E
 Well No. 3 Koenige Koenig

Aikman & Braden Company

COMPLETED Contractor

NW SE SW

SECTION PLAT

 Ft. from N. Line
990 Ft. from S. Line
990 Ft. from E. Line
 Ft. from W. Line

Greenwood County

Location _____

Rig up _____

Drilling and Remarks:

Miss 1870
6" @ 1872
407 to
1500 acid
Pump 4 P2X
280 cu

RECORD

Cased _____ in., _____ ft.
 Sand _____
 Gas _____
 Oil _____
 Total Depth 1872

PRODUCTION

1st 24 hrs. Nat. _____
 1st 24 hrs. after shot _____
 Gas _____ Cu. Ft.
 Dry Hole _____
 Abandoned _____

Date

JUL 17 1946 19 S. J. LEWIS Scout