


Map No. Lansing Sec. 27 Twp. 22 R. 13
Well No. 2 Miller Farm
Braden Bros Company

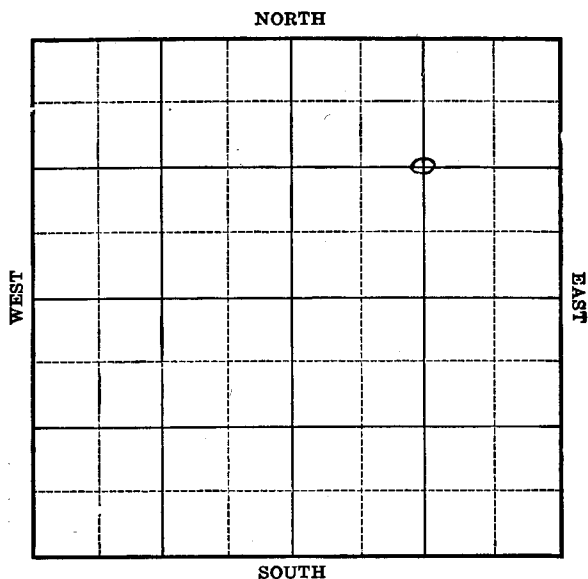

Location _____
Drilling Remarks _____

Rig Up-----
Drilling Remarks


RECORD

Cased _____ in. _____ ft.
Sand _____
Gas _____
Oil _____
Total Depth _____

PRODUCTION

1st 24 hrs. Nat. _____
1st. 24 hrs. after shot _____
Gas _____ cu. ft.
Dry Hole _____
Abandoned _____

Map No. Kansas Sec. 27 Twp. 22 R 13
Well No. 2 Miller Farm
Braden Bros Company

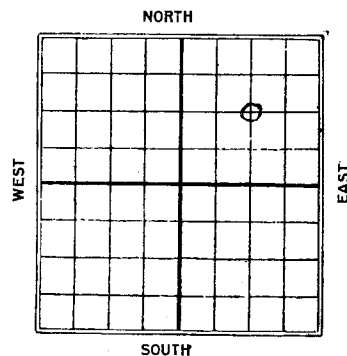

_____ Ft. from N. Line
1320 Ft. from S. Line
1320 Ft. from E. Line
_____ Ft. from W. Line

C.

Date 1925


REPORT

5/21 Rig up
5/29 Sbg 450
6/5 Set 10' 1008 Sbg 1020
6/12 Drelg 1720
6/18 1822-1850 80 gT
75 Bbls

Map No. 27 Sec. 27 Twp. 22 R. 13
Well No. 2 Miller
Braden Bros Company
Contractor

FIRST REPORTS

SECTION PLAT

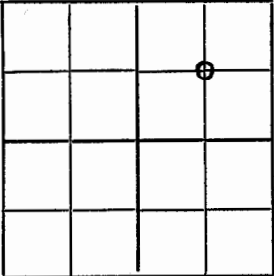

_____ Ft. from N. Line
1320 Ft. from S. Line
1320 Ft. from E. Line
_____ Ft. from W. Line


RECORD	
Location _____	Cased _____ in., _____ ft.
Rig up ☒	Sand _____
Drilling and Remarks:	Gas _____
	Oil _____
	Total Depth _____
	PRODUCTION
	1st 24 hrs. Nat. _____
	1st 24 hrs. after shot _____
	Gas _____ Cu. Ft.
	Dry Hole _____
	Abandoned _____

Date MAY 21 1925
192 **CHAS. L. SHERWOOD** Scout

Map No. 27 Sec. 27 Twp. 22 R. 13
Well No. 2 Miller
Braden Bros Company
Contractor

COMPLETED

SECTION PLAT

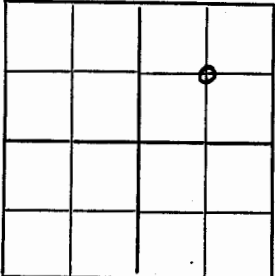

_____ Ft. from N. Line
1320 Ft. from S. Line
1320 Ft. from E. Line
_____ Ft. from W. Line

RECORD	
Location _____	Cased _____ in., _____ ft.
Rig up _____	Sand <u>1822-1850</u>
Drilling and Remarks:	Gas _____
	Oil _____
	Total Depth <u>1850</u>
	PRODUCTION
	1st 24 hrs. Nat. _____
	1st 24 hrs. after shot _____
	Gas _____ Cu. Ft.
	Dry Hole _____
	Abandoned _____

Date JUN 18 1925
192 **CHAS. L. SHERWOOD** Scout