


Map No. 15 Sec. 7 Twp. 22 R. 13  
 Well No. 2 - Storer Farm \_\_\_\_\_  
Empire G. F. Company

NORTH

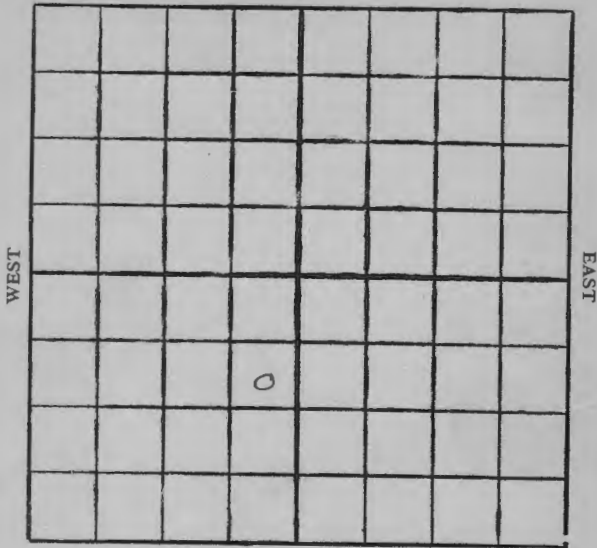

SOUTH

Location \_\_\_\_\_  
 Drilling Remarks \_\_\_\_\_

Rig Up \_\_\_\_\_  
 Drilling Remarks \_\_\_\_\_

RECORD

PRODUCTION


Cased.....in. ....ft.  
 Sand \_\_\_\_\_  
 Gas \_\_\_\_\_  
 Oil \_\_\_\_\_  
 Total Depth \_\_\_\_\_

1st 24 hrs. Nat. \_\_\_\_\_  
 1st 24 hrs. after shot \_\_\_\_\_  
 Gas \_\_\_\_\_ cu. ft.  
 Dry Hole \_\_\_\_\_  
 Abandoned \_\_\_\_\_

Map No. 15 Sec. 7 Twp. 22 R. 13  
 Well No. 2 - Storer Farm \_\_\_\_\_  
Empire G. F. Company

NORTH

990 Ft. from N. Line  
 \_\_\_\_\_ Ft. from S. Line  
230 Ft. from E. Line  
 \_\_\_\_\_ Ft. from W. Line

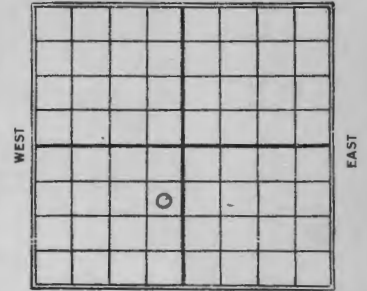

SOUTH

1926

Date \_\_\_\_\_ REPORT

12/2 R.O.G.  
12/8 Bldg rig  
12/15 Rigging up  
12/22 Drlg 300  
12/30 " 425  
1927  
1/6 Drlg - 830  
1/13 sand 1110-15 - T.D. 1129  
 1 bailer oil + 1/2 bailer  
 water 1/4 m gas  
1/19 shut down 1130  
1/26 same  
2/3 \_\_\_\_\_  
2/10 Drlg 7117  
2/17 sand 2262-75 show oil Drlg  
4/24 H.F.W. 2288-91 shut down  
3/2 sand 1110-15 - sho oil + gas  
 sand 2262-75 show  
 oil H.F.W. 2288-91  
 D & A 2291

*Sherwood*

Map No. *1000* KANSAS Sec. *7* Twp. *22* R. *13*

Well No. *2* *Storer*  
*Empire Oil & Gas Co* Company

Contractor

COMPLETED

SECTION PLAT

*990* Ft. from N. Line

Ft. from S. Line

*331* Ft. from E. Line

Ft. from W. Line

ABANDONED

|  |  |  |  |
|--|--|--|--|
|  |  |  |  |
|  |  |  |  |
|  |  |  |  |
|  |  |  |  |
|  |  |  |  |

Location

Rig up

Drilling and Remarks  
*Band 1110-15 Sho*  
*oil 54.*

RECORD

Cased \_\_\_\_\_ in., \_\_\_\_\_ ft.  
Sand \_\_\_\_\_  
Gas \_\_\_\_\_  
Oil \_\_\_\_\_  
Total Depth *2291*

PRODUCTION

1st 24 hrs. Nat. \_\_\_\_\_  
1st 24 hrs. after shot \_\_\_\_\_  
Gas \_\_\_\_\_ Cu. Ft.  
Dry Hole   
Abandoned

Date

MAR 2 1927

CHAS. L. SHERWOOD  
192 Scout

*Sherwood*

Map No. *1000* KANSAS Sec. *7* Twp. *22* R. *13*

Well No. *2* *Storer*  
*Empire Oil & Gas Co* Company

Contractor

FIRST REPORTS

SECTION PLAT

*990* Ft. from N. Line

Ft. from S. Line

*330* Ft. from E. Line

Ft. from W. Line

|  |  |  |  |
|--|--|--|--|
|  |  |  |  |
|  |  |  |  |
|  |  |  |  |
|  |  |  |  |
|  |  |  |  |

Location

Rig up

Drilling and Remarks:

*Roll*

RECORD

Cased \_\_\_\_\_ in., \_\_\_\_\_ ft.  
Sand \_\_\_\_\_  
Gas \_\_\_\_\_  
Oil \_\_\_\_\_  
Total Depth \_\_\_\_\_

PRODUCTION

1st 24 hrs. Nat. \_\_\_\_\_  
1st 24 hrs. after shot \_\_\_\_\_  
Gas \_\_\_\_\_ Cu. Ft.  
Dry Hole \_\_\_\_\_  
Abandoned \_\_\_\_\_

Date

DEC 2 1926

CHAS. L. SHERWOOD  
193 Scout