


KANSAS

Section 7 Township 22 Range 13

Well No. #1 Storrer

Company R.S. Webb et al

NORTH

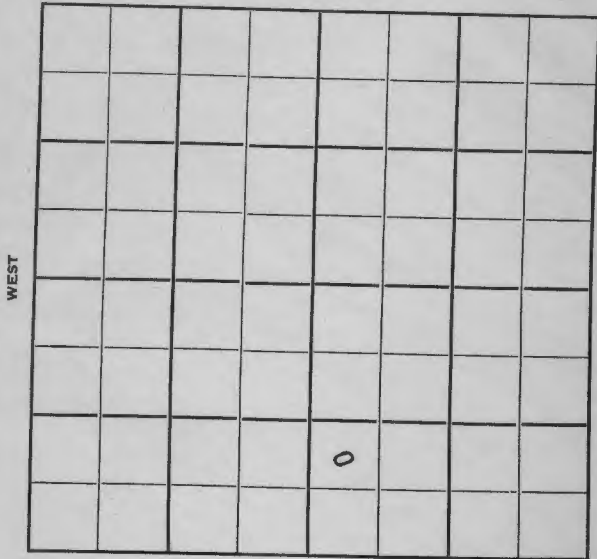

SOUTH

Greenwood KANSAS

Sec. 7 Twp. 22 R. 13

Well No. #1 Storrer Farm

R. S. Webb et al Company

Miscellaneous


_____ Ft. from N. Line

990' Ft. from S. Line

_____ Ft. from E. Line

330' Ft. from W. Line

NW SW SE

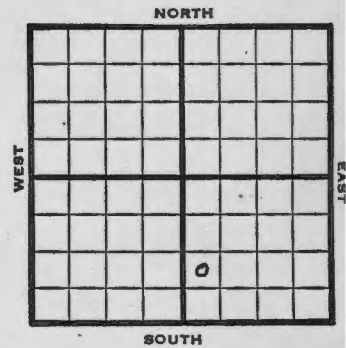

1950

REPORT

1/4

Doug 435'
Lans. 718'
KC 1017'
Miss 1783'
5" @ 2202'
TD 2215'

1/25

5" @ 2202'
Arb 2244'
D&A TD 2265'

ABANDONED

Map No. _____ Sec. 7 Twp. 22 R. 13E

Well No. 1 Storrer

R. S. Webb etal. Company

Contractor

NW SW SE

SECTION PLAT

ABANDONED		

_____ Ft. from N. Line

990 Ft. from S. Line

_____ Ft. from E. Line

330 Ft. from W. Line

Greenwood County

Location _____

RECORD

Cased _____ in., _____ ft.

Sand _____

Gas _____

Oil _____

Total Depth 2265

PRODUCTION

1st 24 hrs. Nat. _____

1st 24 hrs. after shot _____

Gas _____ Cu. Ft.

Dry Hole _____

Abandoned _____

Drilling and Remarks:

5" @ 2202
and 2244

D + A.

Date JAN 25 1950

J. E. TYRA Scout

Map No. _____ Sec. 7 Twp. 22 R. 13E

Well No. 1 Storrer

R. S. Webb etal. Company

Contractor

NW SW SE

SECTION PLAT

_____ Ft. from N. Line

990 Ft. from S. Line

_____ Ft. from E. Line

330 Ft. from W. Line

Greenwood County

Location _____

RECORD

Cased _____ in., _____ ft.

Sand _____

Gas _____

Oil _____

Total Depth _____

PRODUCTION

1st 24 hrs. Nat. _____

1st 24 hrs. after shot _____

Gas _____ Cu. Ft.

Dry Hole _____

Abandoned _____

Drilling and Remarks:

Doug. 435

Lans. 718

KC 1017

Miss. 1783

5" @ 2202

TD 2215

Date

JAN 4 1950 19

J. E. Tyra Scout