


Map No. 2 Sec. 7 Twp. 22 R. 13E
Well No. 2 J. Ott Farm B. Young et al Company

NORTH

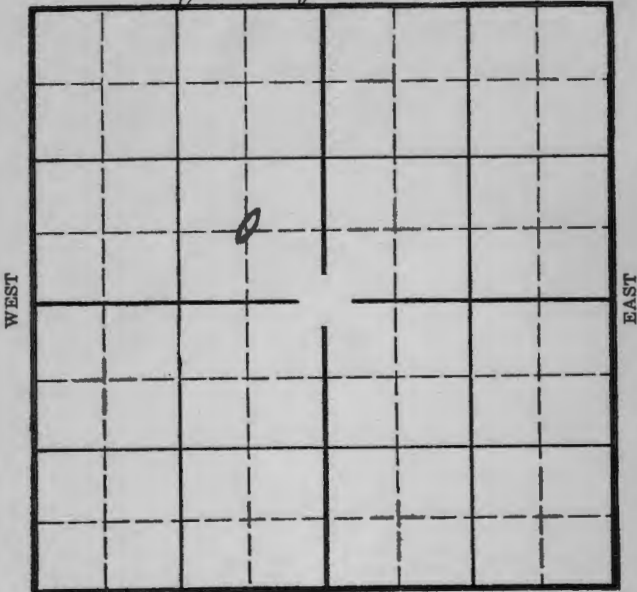

SOUTH

Location
Drilling Remarks


Rig Up
Drilling Remarks

RECORD
Cased _____ in. _____ ft.
Sand _____
Gas _____
Oil _____
Total Depth _____

PRODUCTION
1st 24 hrs. Nat. _____
1st 24 hrs. after shot _____
Gas _____ cu. ft. _____
Dry Hole _____
Abandoned _____

Map No. 2 Sec. 7 Twp. 22 R. 13E
Well No. 2 J. Ott Farm B. Young et al Company

NORTH

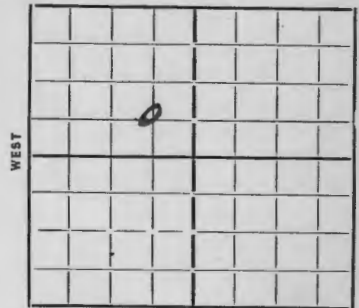

SOUTH

_____ Ft. from N. Line
660 3300
_____ Ft. from S. Line
660 3300
_____ Ft. from E. Line
_____ Ft. from W. Line

REPORT

Date 1935
11/6 Shy 450
11/10 " 720
11/21 5" 1065 Aug 1097-98
11/29 1000 acid
12/11 12/6
12/11 bank 1097
TD 1098
1000 acid
D.O.A.

ABANDONED

Form 26-1M *Greenwood* KANSAS
 Map No. *20* Sec. *7* Twp. *22* R. *13E*
 Well No. *2-9 Ott*
B. Young et al Company
 Contractor

FIRST REPORTS

SECTION PLAT

Ft. from N. Line
660 ³³⁰⁰
 Ft. from S. Line
660 ³³⁰⁰
 Ft. from E. Line
 Ft. from W. Line

	0		

Location.....
 Rig up.....
 Drilling and Remarks:

Qty 450

RECORD
 Cased.....in.,ft.
 Sand.....
 Gas.....
 Oil.....
 Total Depth.....

PRODUCTION
 1st 24 hrs. Nat.....
 1st 24 hrs. after shot.....
 Gas.....Cu. Ft.
 Dry Hole.....
 Abandoned.....

Date *11-6-35* 192..... *ORVAL MANNSCHRECK* Scout

Form 26-1M *Greenwood* KANSAS
 Map No. *20* Sec. *7* Twp. *22* R. *13E*
 Well No. *2-9 Ott*
B. Young et al Company
 Contractor

SECTION PLAT

Ft. from N. Line
660 ³³⁰⁰
 Ft. from S. Line
660 ³³⁰⁰
 Ft. from E. Line
 Ft. from W. Line

	0		

Location.....
 Rig up.....
 Drilling and Remarks:

1000 acid
D. + a.

RECORD
 Cased.....in.,ft.
 Sand.....*1097*
 Gas.....
 Oil.....
 Total Depth.....*1098*

PRODUCTION
 1st 24 hrs. Nat.....
 1st 24 hrs. after shot.....
 Gas.....Cu. Ft.
 Dry Hole.....
 Abandoned.....

Date *12-11-35* 192..... *ORVAL MANNSCHRECK* Scout