


Greenwood

Kansas

Form 51-5M-5-34-Palace

Map No. _____ Sec. 7 Twp. 22 R. 13E
Well No. 1-A Ott Est Farm _____
Young - Reynolds Company

NORTH

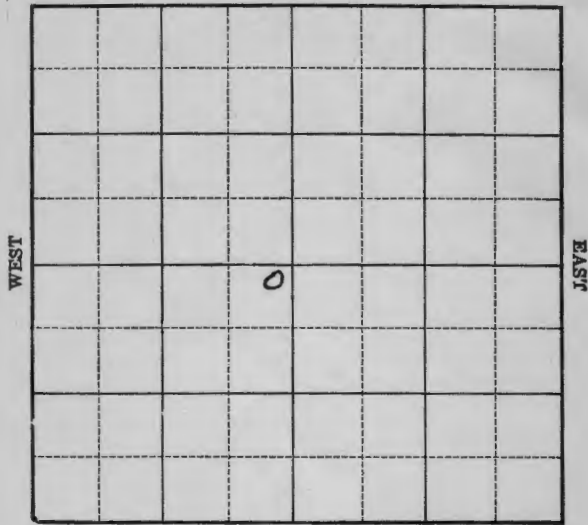

SOUTH

Location

Drilling Remarks

Rig Up

Drilling Remarks

RECORD

Cased _____ in. _____ ft.
Sand _____
Gas _____
Oil _____
Total Depth _____

PRODUCTION


1st 24 hrs. Nat. _____
1st 24 hrs. after shot _____
Gas _____ cu. ft. _____
Dry Hole _____
Abandoned _____

Form 252-A
5M 7-34 MPC

Greenwood

Map No. KANSAS Sec. 7 Twp. 22 R. 13E
Well No. 1-17 Ott Est Farm _____
Young & Reynolds Company

NORTH

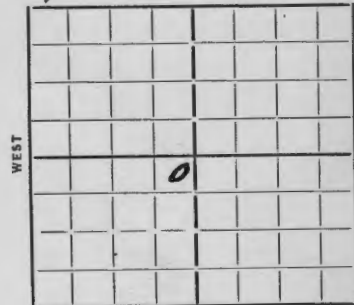

SOUTH

250 Ft. from N. Line

2302 Ft. from S. Line

250 2694 Ft. from E. Line

_____ Ft. from W. Line

TWIN

Date 1935
6/5

REPORT

Ogwego 1058
Pay 1104-07 T. 7
1000 acid
100 oil 25 water.

FIRST REPORT

COMPLETED

Form 28-1M Rev. 3-22-14
Greenwood KANSAS
Map No. *20* Sec. *7* Twp. *22* R. *13E*
Well No. *1A-Ott Est*
Young & Reynolds Company

1st Report Contractor
Completion

SECTION PLAT
250 Ft. from N. Line
2302 Ft. from S. Line
250 Ft. from E. Line
2694 Ft. from W. Line

	0		

Twin
CORRECTION
Location *CORRECT WELL*
Rig up *300X300 to*
Drilling and Remarks:
Oswego 1058
pay 1104-07
100 sand
100 oil
25 water

Well #1 RECORD
Cased _____ in., _____ ft.
Sand _____
Gas _____
Oil _____
Total Depth *1107*
PRODUCTION
1st 24 hrs. Nat. _____
1st 24 hrs. after shot _____
Gas _____ Cu. Ft.
Dry Hole _____
Abandoned _____

Date *6-5-35* 192 _____ Scout
ORVAL MANNSCHRECK