


Map No. KANSAS Sec. 7 Twp. 22 R. 13E
Well No. 1-A att Farm Young & Reynolds Company

Greenwood
22 13E

NORTH

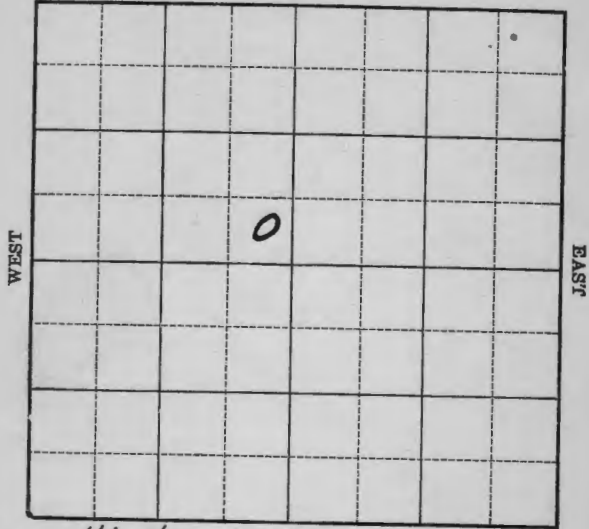

6

SOUTH

Twin Well

Map No. KANSAS Sec. 7 Twp. 22 R. 13E
Well No. 1-A att Farm Young & Reynolds Company

Greenwood

Ft. from N. Line

470 2959 FSL

Ft. from S. Line


2697 FEL

Ft. from E. Line

250

Ft. from W. Line

Twin Well

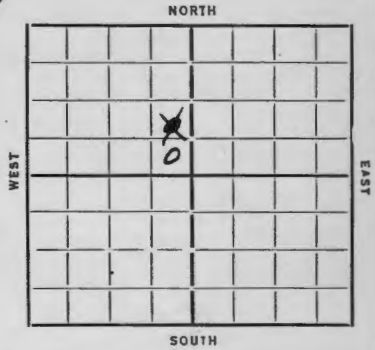

| Date | REPORT |
|------------------|--|
| <u>11/7</u> | <u>Acwago L. 1065</u> <u>Pay 1107-09 1000 acid</u> <u>600' fluid</u> |
| <u>11/15</u> | <u>11/22 — 11/28 —</u> |
| <u>12/5</u> | <u>lime 1065 oil 1107-09</u> <u>1000 acid 75oil 100 water</u> |
| COMPLETED | |

Location _____
Drilling Remarks _____

Rig Up _____
Drilling Remarks _____

RECORD

Cased _____ in. _____ ft.
Sand _____
Gas _____
Oil _____
Total Depth _____


PRODUCTION

1st 24 hrs. Nat. _____
1st 24 hrs. after shot _____
Gas _____ cu. ft. _____
Dry Hole _____
Abandoned _____

Form 204-121-61
 KANSAS
 Map No. 20 Sec. 7 Twp. 22 R. 13 E
 Well No. 1A - Oct
Young & Reynolds Company
 Contractor

Twin well

SECTION PLAT

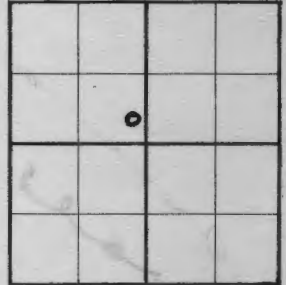

_____ Ft. from N. Line
470 2959 FSL
 Ft. from S. Line
250 2697
 Ft. from E. Line
 _____ Ft. from W. Line

FIRST REPORTS

Location _____

RECORD

Cased _____ in. _____ ft.
 Sand _____
 Gas _____
 Oil _____
 Total Depth _____

Rig up _____

Drilling and Remarks:

2000 gal. 1065
gas 1107-09
1000 acid
600 fluid

PRODUCTION

1st 24 hrs. Nat. _____
 1st 24 hrs. after shot _____
 Gas _____ Cu. Ft.
 Dry Hole _____
 Abandoned _____


Date 11-7-37 1937

ORVAL MANN SCHRECK
 Scout

Form 204-121-61
 KANSAS
 Map No. 20 Sec. 7 Twp. 22 R. 13 E
 Well No. 1A Oct
Young & Reynolds Company
 Contractor

COMPLETED

SECTION PLAT

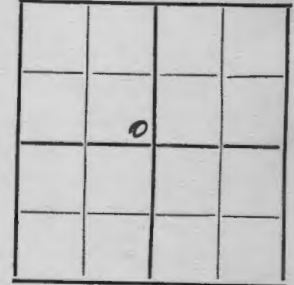

_____ Ft. from N. Line
470 2959 FSL
 Ft. from S. Line
250 2697 FSL
 Ft. from E. Line
 _____ Ft. from W. Line

Location _____

RECORD

Cased _____ in. _____ ft.
 Sand time 1065
 Gas _____
 Oil 1107-09
 Total Depth _____

Rig up _____

Drilling and Remarks:

1000 acid
75 oil
100 water

PRODUCTION

1st 24 hrs. Nat. _____
 1st 24 hrs. after shot _____
 Gas _____ Cu. Ft.
 Dry Hole _____
 Abandoned _____

Date 11-5-37 1937

ORVAL MANN SCHRECK
 Scout