


Map No. _____ Sec. 7 Twp. 22 R. 13
 Well No. 104 Farm _____
Minnehoma Company

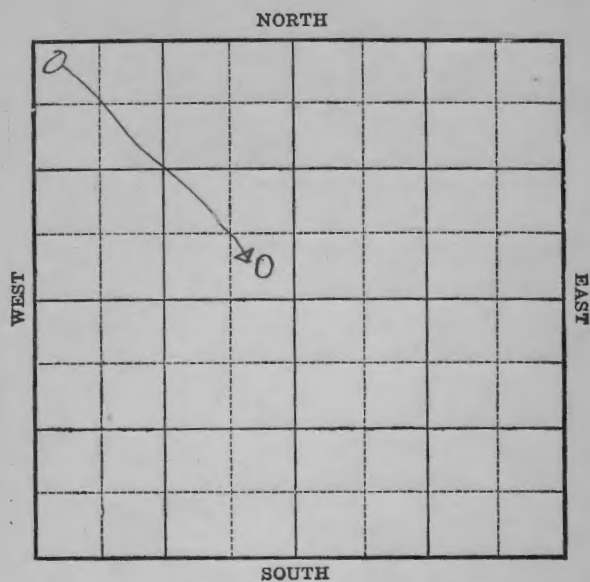

Location _____

Drilling Remarks:

Rig up _____

Drilling Remarks:

RECORD

Cased _____ in. _____ ft.

Sand _____

Gas _____

Oil _____

Total Depth _____

PRODUCTION

1st 24 hrs Nat. _____

1st 24 hrs. after shot _____


Gas _____ cu. ft.

Dry Hole _____

Abandoned _____

Map No. _____ Sec. 7 Twp. 22 R. 13
 Well No. 104 Farm _____
Minnehoma Company

200 Ft. from N. Line
2959 Ft. from S. Line
2697 Ft. from E. Line
200 Ft. from W. Line

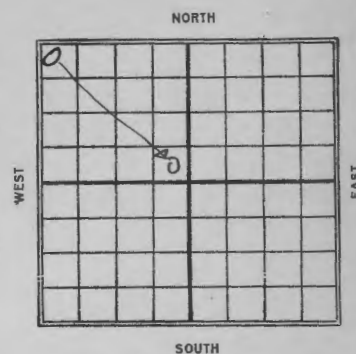Date
1923

REPORT

1/12D+G-2240'

Map No. KANSAS Sec. 7 Twp. 22 R. 13Well No. 1-OTTMinnehoma Company

Contractor

ABANDONED SECTION PLAT

FIRST REPORT

220 Ft. from N. Line2959-66 Ft. from S. Line2697 Ft. from E. Line200 Ft. from W. Line

Location

Rig up

Drilling and Remarks:

2240'
1049

RECORD

Cased in, ft.

Sand

Gas

Oil

Total Depth

PRODUCTION

1st 24 hrs. Nat.

1st 24 hrs. after shot

Gas Cu. Ft.

Dry Hole

Abandoned

Date

JAN 12 1923M. A. BENEAR

Scout