


Map No. 7 Sec. 22 Twp. 7 R. 13E  
Well No. #1-A Adams Farm  
Young & Reynolds Company

Greenwood

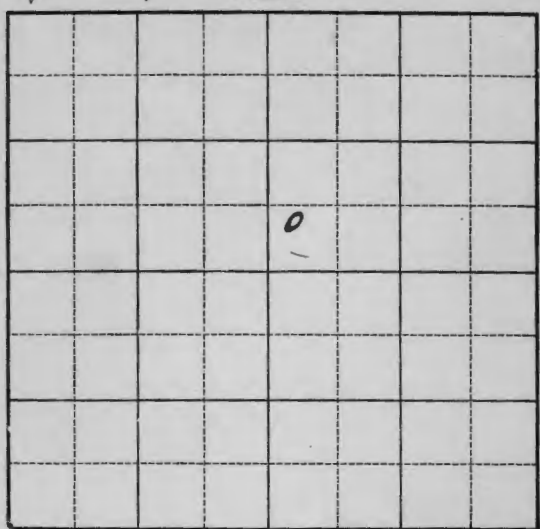

Location \_\_\_\_\_  
Drilling Remarks \_\_\_\_\_  
\_\_\_\_\_  
\_\_\_\_\_  
\_\_\_\_\_  
\_\_\_\_\_  
\_\_\_\_\_  
\_\_\_\_\_  
\_\_\_\_\_  
\_\_\_\_\_

Rig Up \_\_\_\_\_  
Drilling Remarks \_\_\_\_\_  
\_\_\_\_\_  
\_\_\_\_\_  
\_\_\_\_\_  
\_\_\_\_\_  
\_\_\_\_\_  
\_\_\_\_\_  
\_\_\_\_\_  
\_\_\_\_\_


**RECORD**  
Cased \_\_\_\_\_ in. \_\_\_\_\_ ft.  
Sand \_\_\_\_\_  
Gas \_\_\_\_\_  
Oil \_\_\_\_\_  
Total Depth \_\_\_\_\_

**PRODUCTION**  
1st 24 hrs. Nat. \_\_\_\_\_  
1st 24 hrs. after shot \_\_\_\_\_  
Gas \_\_\_\_\_ cu. ft. \_\_\_\_\_  
Dry Hole \_\_\_\_\_  
Abandoned \_\_\_\_\_

Map No. 7 Sec. 22 Twp. 7 R. 13E  
Well No. 1-A Adams Farm  
Young & Reynolds Company

Greenwood

Ft. from N. Line  
470 3289 FSL  
Ft. from S. Line  
179  
Ft. from E. Line  
250  
Ft. from W. Line

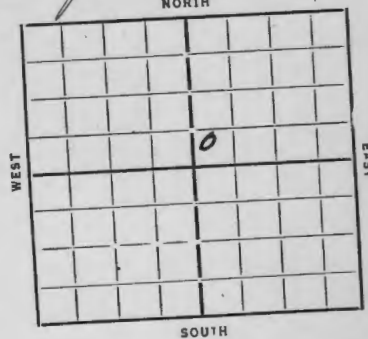

Date 1985  
1/30 log 800  
2/7 log 900  
2/14  
2/20 T.L. 1078 T 1100 17A  
**ABANDONED**

REPORT

**Greenwood**  
 Form No. 114, Rev. 1-22  
 Map No. 20 Sec. 7 Twp. 22 R. 13E  
 Well No. 1A-Adams  
Young & Reynolds Company  
 Contractor

**FIRST REPORTS**

Ft. from N. Line  
470 3289 FSL  
 Ft. from S. Line  
 1799 Ft. from E. Line  
250 Ft. from W. Line

**SECTION PLAT**

		o	

Location.....  
 Rig up.....  
 Drilling and Remarks:

*log 800'*

**RECORD**  
 Cased..... in., ..... ft.  
 Sand.....  
 Gas.....  
 Oil.....  
 Total Depth.....

**PRODUCTION**  
 1st 24 hrs. Nat.....  
 1st 24 hrs. after shot.....  
 Gas..... Cu. Ft.  
 Dry Hole.....  
 Abandoned.....

Date 1-30-35 192..... **ORVAL MANNSCHECK** Scout

**Greenwood**  
 Form No. 114, Rev. 1-22  
 Map No. 20 Sec. 7 Twp. 22 R. 13E  
 Well No. 1A-Adams  
Young & Reynolds Company  
 Contractor

**ABANDONED**

Ft. from N. Line  
470 3289 FSL  
 Ft. from S. Line  
 1799 Ft. from E. Line  
250 Ft. from W. Line

**SECTION PLAT**

		o	

Location.....  
 Rig up.....  
 Drilling and Remarks:

*10 + 17*

**RECORD**  
 Cased..... in., ..... ft.  
 Sand 1078  
 Gas.....  
 Oil.....  
 Total Depth 1100

**PRODUCTION**  
 1st 24 hrs. Nat.....  
 1st 24 hrs. after shot.....  
 Gas..... Cu. Ft.  
 Dry Hole.....  
 Abandoned.....

Date 2-20-35 192..... **ORVAL MANNSCHECK** Scout