
DX 78-1

Marion KANSAS

Section 13 Township 22 Range 3E

Well No. 1 Spier

Company Beaumont Petr.

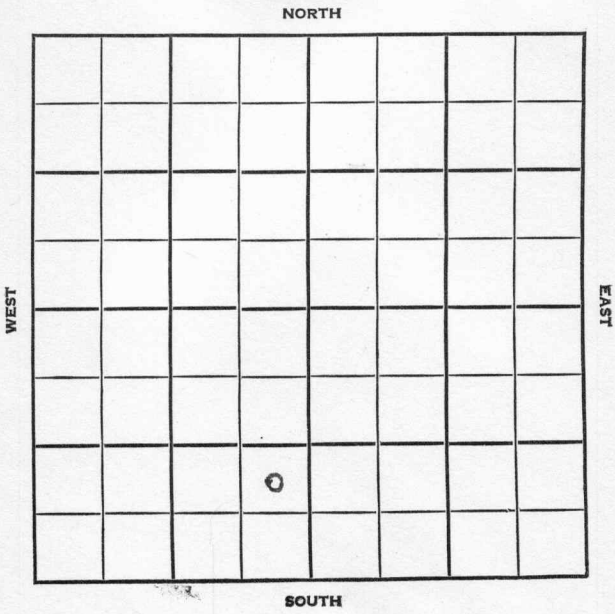

Marion KANSAS

SEC.	TWP.	R.
13	22	3 E

WELL NO.
1 Spier FARM

COMPANY
Beaumont Petr.

CONTRACTOR
Co. Tools
Wildcat


_____ Ft. from N. Line

990 Ft. from S. Line

330 Ft. from E. Line

_____ Ft. from W. Line

NE SE SW

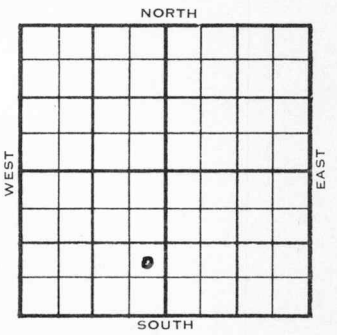

1955	ELEVATION -	REPORT
2/9		Spud 2-7-55
2/23		Spud 2-7-55 - D&A TD 2604' 8" @ 97' Lans. 1962', B KC 2332', ~~MKKK~~ Marm. 2388', Cherokee 2516', Cong. 2533', Miss. 2564' DST 2564-75', opn 45", rec. 75' m&w 625# TD 2604' D&A

ABANDONED

DX-78

FORM 275 FOR SALE BY KANSAS BLUE PRINT CO.


County Marion State Kansas

Sec. 13 (Blk. Twp.) 22 (Sur. Rge.) 3E Map No.

Operator Beaumont Pet.

Well No. 1 Farm Spier

Elev. Location NE SE SW

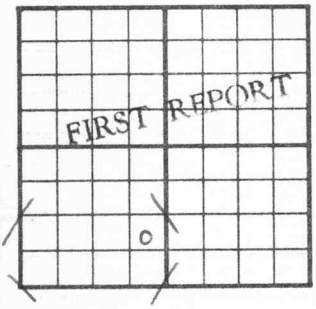

990 Ft. From S Line SW

330 Ft. From E Line Quarter

1st. Report FEB 9 1955

Completion

Remarks

Co. tools

Spudding Date 2-7-55

Drlg. Data Wildcat

FABEN GILSTRAP

FORM 275 FOR SALE BY KANSAS BLUE PRINT CO.


County Marion State Kansas

Sec. 13 (Blk. Twp.) 22 (Sur. Rge.) 3E Map No.

Operator Beaumont Pet.

Well No. 1 Farm Spier

Elev. Location NE SE SW

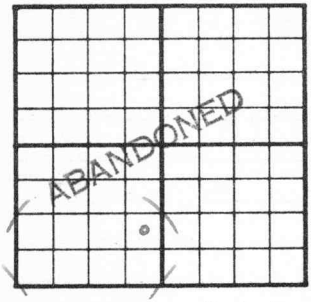

990 Ft. From S Line SW

330 Ft. From E Line Quarter

1st. Report

Completion FEB 23 1955

Remarks Wildcat
Co. tools

Spudding Date 2-7-55

Drlg. Data D & A TD 2604

8" @ 97 Lans. 1962 B KC 2332

Marm. 2388 Cherokee 2516 Cong. 2533

Miss. 2564 DST 2564-75 open 45 min.

Rec. 75' m & w 625# TD 2604

D & A

FABEN GILSTRAP