


Map No. Kans Sec. 13 Twp. 22 R. 10

Well No. 2 Derbyshire Farm  
Prior + Lockhart Company

NORTH

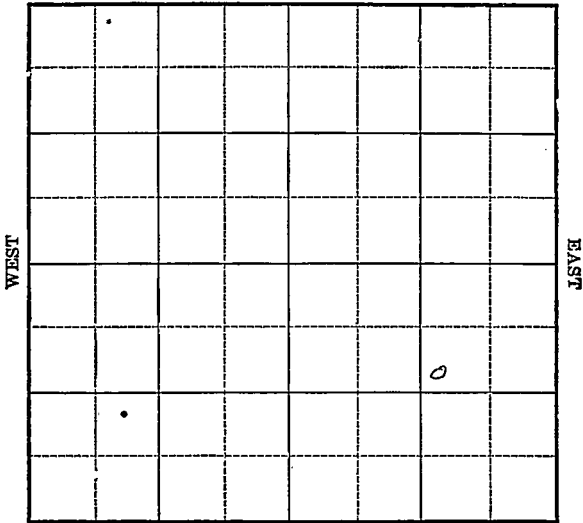

SOUTH

Location \_\_\_\_\_  
Drilling Remarks \_\_\_\_\_

Rig Up \_\_\_\_\_  
Drilling Remarks \_\_\_\_\_

\_\_\_\_\_  
\_\_\_\_\_  
**RECORD**

Cased \_\_\_\_\_ in. \_\_\_\_\_ ft.  
Sand \_\_\_\_\_  
Gas \_\_\_\_\_  
Oil \_\_\_\_\_  
Total Depth \_\_\_\_\_

**PRODUCTION**

1st 24 hrs. Nat. \_\_\_\_\_  
1st. 24 hrs. after shot \_\_\_\_\_  
Gas \_\_\_\_\_ cu. ft.  
Dry Hole \_\_\_\_\_  
Abandoned \_\_\_\_\_



21 **KANSAS** Map No. Sec. 13 Twp 22 R. 10

Well No. 2 *Larkenshire*  
*Prinn & Larkenshire* Company

Contractor

**FIRST REPORT**

**SECTION PLAT**

1020 Ft. from N. Line

\_\_\_\_\_ Ft. from S. Line

1020 Ft. from E. Line

\_\_\_\_\_ Ft. from W. Line


Location \_\_\_\_\_

Rig up \_\_\_\_\_

Drilling and Remarks:

*spud*

**RECORD**

Cased \_\_\_\_\_ in., \_\_\_\_\_ ft.

Sand \_\_\_\_\_

Gas \_\_\_\_\_

Oil \_\_\_\_\_

Total Depth \_\_\_\_\_

**PRODUCTION**

1st 24 hrs. Nat. \_\_\_\_\_

1st 24 hrs. after shot \_\_\_\_\_

Gas \_\_\_\_\_ Cu. Ft.

Dry Hole \_\_\_\_\_

Abandoned \_\_\_\_\_

Date DEC 11 1924

**M. A. BENEAR**

192\_\_\_\_\_

Scout

Map No. 2 ~~KANSAS~~ Sec. 13 Twp. 22 R. 10 *Greenwood*

Well No. 2 *Derbyshire*

*Bryan & Lockhart* Company

Contractor

**ABANDONED SECTION PLAT**

1020 Ft. from N. Line

\_\_\_\_\_ Ft. from S. Line

11020 Ft. from E. Line

\_\_\_\_\_ Ft. from W. Line

			0

Location \_\_\_\_\_

Rig up \_\_\_\_\_

Drilling and Remarks:

*LOVA 2180'*  
*770 sand.*

**RECORD**

Cased \_\_\_\_\_ in., \_\_\_\_\_ ft.

Sand \_\_\_\_\_

Gas \_\_\_\_\_

Oil \_\_\_\_\_

Total Depth \_\_\_\_\_

**PRODUCTION**

1st 24 hrs. Nat. \_\_\_\_\_

1st 24 hrs. after shot \_\_\_\_\_

Gas \_\_\_\_\_ Cu. Ft.

Dry Hole \_\_\_\_\_

Abandoned \_\_\_\_\_

Date

*1/21* *5*

**M. A. BENEAR**