

Greenwood

Map No. *1/land* Sec. *13* Twp. *22* R. *10*


Well No. *3* *Serby Shire* Farm
Pryor + Lackhart Company

200 Ft. from N. Line

..... Ft. from S. Line

660 Ft. from E. Line

..... Ft. from W. Line

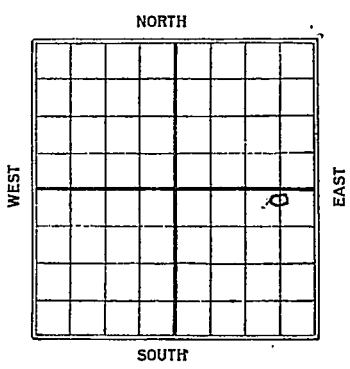

Date
1925

REPORT

2/8 Location

3/30 Sand 2097-2141

T.D. 2143 120 gts 397 Bbl

Map No. 21 **KANSAS** Sec. 13 Twp. 32 R. 10

Well No. 3 Derby shire
Ryan & Lackhart Company

Contractor

FIRST REPORT

SECTION PLAT

200' Ft. from N. Line

_____ Ft. from S. Line

660' Ft. from E. Line

_____ Ft. from W. Line

			0'

Location ✓✓

Rig up _____

Drilling and Remarks:

RECORD

Cased _____ in., _____ ft.

Sand _____

Gas _____

Oil _____

Total Depth 200'

PRODUCTION

1st 24 hrs. Nat. _____

1st 24 hrs. after shot _____

Gas _____ Cu. Ft.

Dry Hole _____

Abandoned _____

Date

2/7 1925

M. A. BENEAR

Scout

Greenwood

Map No. *Kansas* Sec. *13* Twp. *22* R. *10*

Well No. *3 Derbyshire*

Pryor & Lockhart Company

Contractor

SECTION PLAT

200 Ft. from N. Line

_____ Ft. from S. Line

660 Ft. from E. Line

_____ Ft. from W. Line

			o

Location _____

Rig up _____

Drilling and Remarks:

RECORD

Cased _____ in., _____ ft.

Sand _____

Gas _____

Oil _____

Total Depth _____

PRODUCTION

1st 24 hrs. Nat. _____

1st 24 hrs. after shot _____

Gas _____ Cu. Ft.

Dry Hole _____

Abandoned _____

Date

3/30 1925

M.A. Bernal Scout

Fixed up while in office

21 **KANSAS**
 Map No. _____ Sec. 13 Twp. 22 R. 10

Well No. 3 Leubyshio

Argus & Lockhart Company
 Contractor

COMPLETED SECTION PLAT

200' Ft. from N. Line

_____ Ft. from S. Line

660' Ft. from E. Line

_____ Ft. from W. Line

			0

Location _____

Rig up _____

Drilling and Remarks:

sand 2097-2141
J.D. 2143
120/397 110,

RECORD

Cased _____ in., _____ ft.

Sand _____

Gas _____

Oil _____

Total Depth _____

PRODUCTION

1st 24 hrs. Nat. _____

1st 24 hrs. after shot _____

Gas _____ Cu. Ft.

Dry Hole _____

Abandoned _____

Date

M. A. BENEAR

3/30 192 3

Scout

Map No. _____ Sec. 13 Twp. 27S R. 10E

Well No. 3 Serbyshire

Herwood Oil Co formerly Company
Pryor et al Contractor

SECTION PLAT

300 Ft. from N. Line

_____ Ft. from S. Line

660 Ft. from E. Line

_____ Ft. from W. Line

		<u>13</u>	<u>13</u>

Location _____

Rig up _____

Drilling and Remarks:

RECORD

Cased _____ in., _____ ft.

Sand _____

Gas _____

Oil _____

Total Depth _____

PRODUCTION

1st 24 hrs. Nat. _____

1st 24 hrs. after shot _____

Gas _____ Cu. Ft.

Dry Hole _____

Abandoned _____

abd. Oil Tree

Date

4-10-45 St. Herwin Scout