

Map No. Kane Sec. 13 Twp. 22 R. 10

Well No. 2 Kupper Farm
Mc Ginnis et al Company

_____ Ft. from N. Line


1120

~~200~~ Ft. from S. Line

_____ Ft. from E. Line

1120

~~200~~ Ft. from W. Line

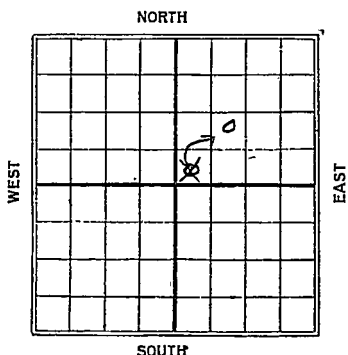

Date 1925	REPORT
<u>1/14</u>	<u>Location</u>
<u>1/21</u>	_____
<u>4/10</u>	<u>2115-2120 T.D. 2143</u>
	<u>60 gals 200 Bbls</u>

KANSAS

Map No. 21 Greenwood Sec. 13 Twp. 22 R. 10

Well No. 2 Kip per
Mr Ginn's et al Company

Contractor

Well Record

SECTION PLAT

_____ Ft. from N. Line

200 Ft. from S. Line

_____ Ft. from E. Line

200 Ft. from W. Line

		o	

Location _____

Rig up _____

Drilling and Remarks:

Log,

RECORD

Cased _____ in., _____ ft.

Sand _____

Gas _____

Oil _____

Total Depth _____

PRODUCTION

1st 24 hrs. Nat. _____

1st 24 hrs. after shot _____

Gas _____ Cu. Ft.

Dry Hole _____

Abandoned _____

Date

M. A. BENEAR

1/14 1925

Scout

Map No. 21 Rbnds Sec. 13 Twp. 22 R. 10^E

Well No. 2 Rcp 201

Mc Dennis et al Company

Contractor

COMPLETED

SECTION PLAT

_____ Ft. from N. Line

1120 Ft. from S. Line

_____ Ft. from E. Line

1120 Ft. from W. Line

		o	

Location _____

Rig up _____

Drilling and Remarks:

shot 60 gts

200 bls

RECORD

Cased _____ in., _____ ft.

Sand 2115' 1st oil 2120'

Gas _____

Oil _____

Total Depth 2142'

PRODUCTION

1st 24 hrs. Nat. _____

1st 24 hrs. after shot _____

Gas _____ Cu. Ft.

Dry Hole _____

Abandoned _____

Date

APR 10 1925

192

Chas. L. Shewee
Scout