


Map No. _____ Sec 14 Twp. 22 R. 4
Well No. L. Rodney Farm _____
Patton Etal Company

NORTH

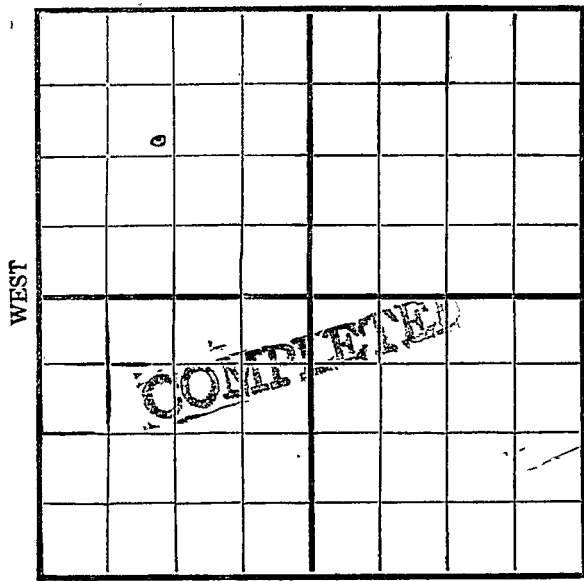

SOUTH

Location _____

Rig Up _____

Drilling Remarks:

Drilling Remarks:

~~RECORD~~

~~PRODUCTION~~

Cased _____ in. _____ ft.

1st 24 hrs. Nat. _____

Sand _____

1st 24 hrs. after shot _____

Gas _____

Gas _____ cu. ft.

Oil _____

Dry Hole _____

Total Depth _____

Abandoned _____

Map No. _____ Sec. 14 Twp. 22 R. 4

Well No. 4 Rodner Farm

Tatton et al Company

Contractor


MM Quarter

1170 Ft. from N. Lice

_____ Ft. from S. Line

_____ Ft. from E. Line

1150 ²⁰⁰ Ft. from W. Line

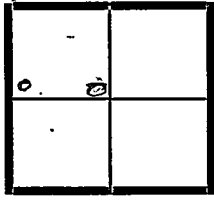

Date

REPORT

<u>10/19</u>	
<u>10/13</u>	Rig
<u>10/20</u>	Rig up.
<u>10/30</u>	Rig up.
<u>11/4</u>	Rig
<u>7</u>	Rig
<u>18</u>	Rig
<u>24</u>	Rig up.
<u>17/1</u>	Rig
<u>8</u>	Rig up
<u>15</u>	Rig up.
<u>22</u>	" "
<u>31</u>	Rig
<u>1/1/20</u>	Rig
<u>15</u>	Rig
<u>19</u>	✓
<u>26</u>	✓
<u>9/2</u>	✓
<u>9</u>	Rig up
<u>16</u>	✓
<u>21</u>	Rig
<u>3/1</u>	Rig moved out

COMPLETED

Map No. K22 Sec 14 Twp. 22 R. 4

Well No. 2 Rodner
Patton et al Company

Contractor

SECTION PLAT

1120 Ft. from N. Line

----- Ft. from S. Line

----- Ft. from E. Line

1120 Ft. from W. Line

FIRST REPORT

Location -----

Rig up -----

Drilling and Remarks:

RECORD

Cased ----- in., ----- ft.

Sand -----

Gas -----

Oil -----

Total Depth -----

PRODUCTION

1st 24 hrs. Nat. -----

1st 24 hrs. after shot -----

Gas ----- Cu. Ft.

Dry Hole -----

Abandoned -----

Date

9/15 1919

Pyle

Scout

Map No. K 23 Sec. 14 Twp. 22 R. 4

Well No. 2 Rodner

Tatton et al Company

Contractor

SECTION PLAT

1120 Ft. from N. Line

----- Ft. from S. Line

----- Ft. from E. Line

1120 Ft. from W. Line

0			

RECORD

Location -----

Rig up -----

Drilling and Remarks:

Cased ----- in., ----- ft.

Sand -----

Gas -----

Oil -----

Total Depth -----

PRODUCTION

1st 24 hrs. Nat. -----

1st 24 hrs. after shot -----

Gas ----- Cu. Ft.

Dry Hole -----

Abandoned -----

Date

9/22 1919

Pyle

Scout

Map No. 1523 Sec. 14 Twp. 22 R. 4

Well No. 2 Rodner
Patton et al Company

Contractor

SECTION PLAT

1120 Ft. from N. Line

_____ Ft. from S. Line

_____ Ft. from E. Line

1120 Ft. from W. Line

o			

Location _____

Rig up

Drilling and Remarks:

RECORD

Cased _____ in., _____ ft.

Sand _____

Gas _____

Oil _____

Total Depth _____

PRODUCTION

1st 24 hrs. Nat. _____

1st 24 hrs. after shot _____

Gas _____ Cu. Ft.

Dry Hole _____

Abandoned _____

Date

9/29 1919

Pyle.

Scout

Map No. K23 Sec. 14 Twp. 22 R. 4

Well No. 2 Rodner
Patton et al Company

Contractor

SECTION PLAT

1120 Ft. from N. Line

----- Ft. from S. Line

----- Ft. from E. Line

200 Ft. from W. Line

0			

Location -----

Rig up -----

Drilling and Remarks:

RECORD

Cased ----- in., ----- ft.

Sand -----

Gas -----

Oil -----

Total Depth -----

PRODUCTION

1st 24 hrs. Nat. -----

1st 24 hrs. after shot -----

Gas ----- Cu. Ft.

Dry Hole -----

Abandoned -----

Date

10/20 1919

Pyle

Scout

Map No. K23 Sec. 14 Twp. 22 R. 4

Well No. 2 Rodner
Patton et al Company

Contractor

SECTION PLAT

1120 Ft. from N. Line

----- Ft. from S. Line

----- Ft. from E. Line

1120 Ft. from W. Line

o			

Location -----

Rig up -----

Drilling and Remarks:

RECORD

Cased ----- in., ----- ft.

Sand -----

Gas -----

Oil -----

Total Depth -----

PRODUCTION

1st 24 hrs. Nat. -----

1st 24 hrs. after shot -----

Gas ----- Cu. Ft.

Dry Hole -----

Abandoned -----

Date

10/6 1919

Pyle

Scout

Map No. K23 Sec. 14 Twp. 22 R. 4

Well No. 2 Rodner
Patton et al Company

Contractor

SECTION PLAT

1120 Ft. from N. Line

_____ Ft. from S. Line

_____ Ft. from E. Line

200 Ft. from W. Line

Correction

0			
change			sec

Location _____

Rig up _____

Drilling and Remarks:

Rig

RECORD

Cased _____ in., _____ ft.

Sand _____

Gas _____

Oil _____

Total Depth _____

PRODUCTION

1st 24 hrs. Nat. _____

1st 24 hrs. after shot _____

Gas _____ Cu. Ft.

Dry Hole _____

Abandoned _____

Date

10/13 1919

Pyle

Scout

Map No. K 23 Sec. 14 Twp. 22 R. 4

Well No. 2 Rodner
Patton et al Company

Contractor

SECTION PLAT

1120 Ft. from N. Line

_____ Ft. from S. Line

_____ Ft. from E. Line

200 Ft. from W. Line

COMPLETED

Location _____

Rig up _____

Drilling and Remarks:

Rig moved out

RECORD

Cased _____ in., _____ ft.

Sand _____

Gas _____

Oil _____

Total Depth _____

PRODUCTION

1st 24 hrs. Nat. _____

1st 24 hrs. after shot _____

Gas _____ Cu. Ft.

Dry Hole _____

Abandoned _____

Date

3/1 1920

Pyle

Scout

MAP NO. _____ SEC. 14 TWP. 27S R. 4E

WELL NO. 2 Rodney

Patton Oil COMPANY

CONTRACTOR _____

SECTION PLAT

<u>0</u>			

_____ FT. FROM N. LINE

_____ FT. FROM S. LINE

_____ FT. FROM E. LINE

_____ FT. FROM W. LINE

LOCATION ✓ _____

RIG UP _____

DRILLING AND REMARKS:

Handwritten notes:
~~rod~~
~~hole~~

RECORD

CASED _____ IN., _____ FT.

SAND _____

GAS _____

OIL _____

TOTAL DEPTH _____

PRODUCTION

1ST 24 HRS. NAT. _____

1ST 24 HRS. AFTER SHOT _____

GAS _____ CU. FT.

DRY HOLE _____

ABANDONED ✓

DATE Sept 13 1920

SCOUT