


Map No. 123 Sec. 14 Twp. 22 R. 4
Well No. 3 Clark Farm
Conservative Oil Co. Company

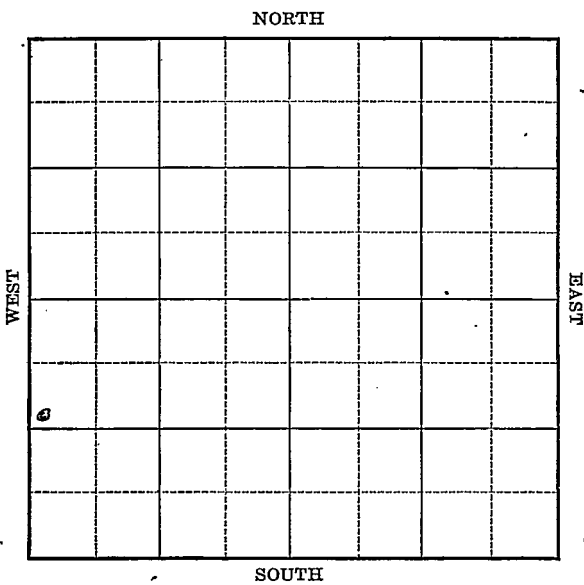

Location _____

Drilling Remarks:

Rig Up _____

Drilling Remarks:

RECORD

Cased _____ in. _____ ft.

Sand _____

Gas _____

Oil _____

Total Depth _____

PRODUCTION

1st 24 hrs. Nat. _____

1st 24 hrs. after shot _____

Gas _____ cu. ft.

Dry Hole _____

Abandoned _____

Map No. K23 Sec. 14 Twp. 22 R. 4

Well No. 3 Clark

Conservative Oil Ref Company

Contractor

SECTION PLAT

1120 Ft. from N. Line

----- Ft. from S. Line

----- Ft. from E. Line

200 Ft. from W. Line

FIRST REPORT

CHANGE LESSEE NAME

Location -----

Rig up -----

Drilling and Remarks:

Spud

RECORD

Cased ----- in., ----- ft.

Sand -----

Gas -----

Oil -----

Total Depth -----

PRODUCTION

1st 24 hrs. Nat. -----

1st 24 hrs. after shot -----

Gas ----- Cu. Ft.

Dry Hole -----

Abandoned -----

Date

8/16 1910

Pyle

Scout

Map No. K 23 Sec. 14 Twp. 22 R. 4

Well No. 3 Clark

Conservative O. & Ref Company

Contractor

SECTION PLAT

1120 Ft. from N. Line

----- Ft. from S. Line

----- Ft. from E. Line

200 Ft. from W. Line

COMPLETED

Location -----

Rig up -----

Drilling and Remarks:

RECORD

Cased _____ in., _____ ft.
 Sand 25 3/4 - 35
 Gas -----
 Oil -----
 Total Depth -----

PRODUCTION

1st 24 hrs. Nat. 280 bbl
 1st 24 hrs. after shot -----
 Gas ----- Cu. Ft.
 Dry Hole -----
 Abandoned -----

Date Jan 30 1921

Pyle

Scout