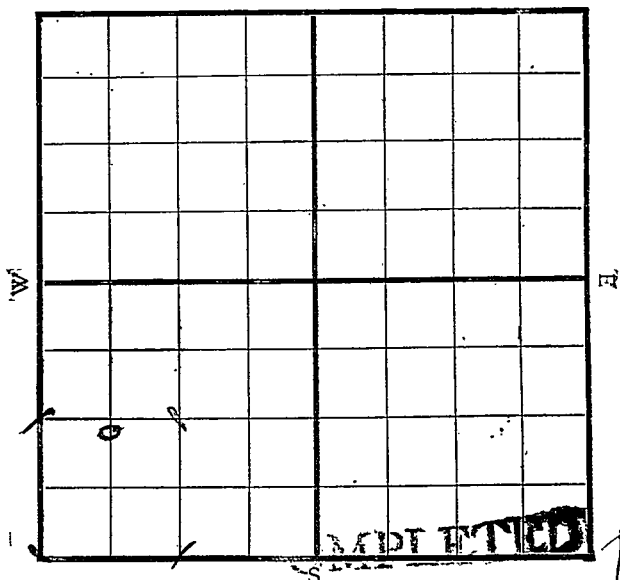


Map No. _____ Sec. 14 Twp. 22 R. 4
 Well No. 2 Clark Farm _____
National Oil Company

N



Location _____

Drilling Remarks:

Rig Up _____

Drilling Remarks:

RECORD

Cased _____ in. _____ ft.

Sand _____

Gas _____

Oil _____

Total Depth _____

PRODUCTION

1st 24 hrs. Nat. _____

1st 24 hrs. after shot _____

Gas _____ cu. ft.

Dry Hole _____

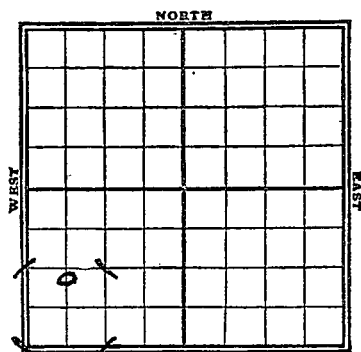
Abandoned _____

Map No. _____ Sec. 14 Twp. 22 R. 4Well No. 2 Clark Farm _____
National Oil Company

_____ Ft. from N. Line

1120 Ft. from S. Line

_____ Ft. from E. Line

660 Ft. from W. Line

REPORT

WASTE REPO.

COMPLETED

14/207/1219268/28/9168/238/319/13202712/15

Well @ 410'

Well 750'

Well @ 1000'

10" @ 1330'

avg 1820

2 150'

Sand 2537-38-200'
oil 100' water2537-38-100 bbls.
oil - 120 bbls. water.

Map No. K23 Sec. 14 Twp. 22 R. 4Well No. 2 ClarkNational Oil Company

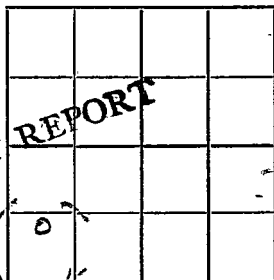
Contractor

SECTION PLAT

Ft. from N. Line

1120 Ft. from S. Line

Ft. from E. Line

660 Ft. from W. Line

Location

Rig up ☒

Drilling and Remarks:

RECORD

Cased _____ in., _____ ft.

Sand _____

Gas _____

Oil _____

Total Depth _____

PRODUCTION

1st 24 hrs. Nat. _____

1st 24 hrs. after shot _____

Gas _____ Cu. Ft.

Dry Hole _____

Abandoned _____

Date

7/12 19120Pyle Scout

Map No. K14 Sec. 14 Twp. 22 R. 4Well No. 2 ClarkNational Oil Company

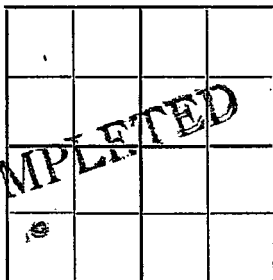
Contractor

SECTION PLAT

Ft. from N. Line

1120 Ft. from S. Line

Ft. from E. Line

660 Ft. from W. Line

Location

Rig up

Drilling and Remarks:

100 bbls Oil
120 bbls water

RECORD

Cased _____ in., _____ ft.

Sand 2537-38

Gas _____

Oil _____

Total Depth _____

PRODUCTION

1st 24 hrs. Nat. _____

1st 24 hrs. after shot _____

Gas _____ Cu. Ft.

Dry Hole _____

Abandoned _____

Date

10 18 1920

Pyle

Scout