


Map No. 11 23 Sec. 14 Twp. 22 R. 4

Well No. 2 Clark Farm

Mountain & Gulf Company

NORTH

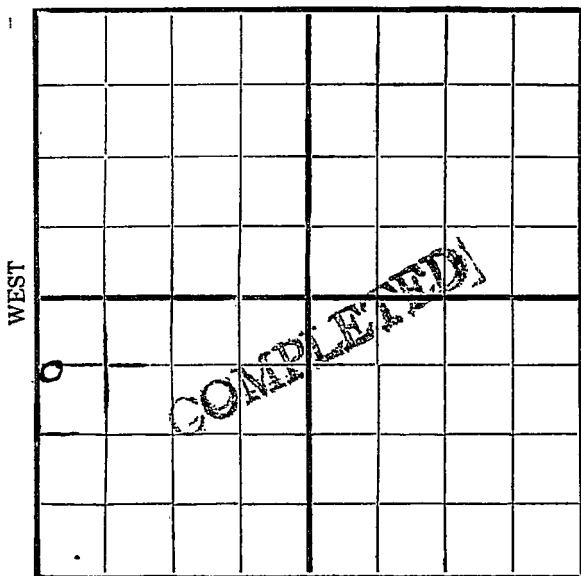

12

SOUTH

Location -----

Rig Up -----

Drilling Remarks:

Drilling Remarks:

-----

-----

RECORD

PRODUCTION

Cased ----- in. ----- ft.

1st 24 hrs. Nat. -----

Sand -----

1st 24 hrs. after shot -----

Gas -----

Gas ----- cu. ft.

Oil -----

Dry Hole -----

Total Depth -----

Abandoned -----

Map No. \_\_\_\_\_ Sec. 14 Twp. 22 R. 4

Well No. Clark Farm \_\_\_\_\_

Maintain Gulf Oil Company \_\_\_\_\_

Contractor \_\_\_\_\_


\_\_\_\_\_ SW Quarter

660 Ft. from N. Line

\_\_\_\_\_ Ft. from S. Line

\_\_\_\_\_ Ft. from E. Line

200 Ft. from W. Line

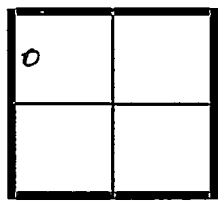

Date \_\_\_\_\_ REPORT

10/19	
10/13	Spool & P.D.
10/20	Run up.
10/30	" "
1/4	land.
12	oil 250.
18	oil 500
24	dry. 1100'
12/1	dry 1300
8	oil. 1300'
15	oil 1300'
22	oil. 1300'
31	✓ ✓
1/6/20	1300'
13	oil 1650'
19	oil 1830'
26	8 1/4 - 1960'
2/2	oil 2100'
9	oil. 2100'
16	oil 2360'
21	2539' - 45' (2500' fluid)
3/1	2539-45' - pulling big pipe
8	2539' - 45' - 400 Bbl

Map No. T 23 Sec. 14 Twp. 22 R. 4

Well No. 2 Clark

Mountain & Gulf Company

Contractor

SECTION PLAT

660 Ft. from N. Line

----- Ft. from S. Line

----- Ft. from E. Line

200 Ft. from W. Line


FIRST REPORT

Location -----

Rig up

Drilling and Remarks:

RECORD

Cased ----- in., ----- ft.

Sand -----

Gas -----

Oil -----

Total Depth -----

PRODUCTION

1st 24 hrs. Nat. -----

1st 24 hrs. after shot -----

Gas ----- Cu. Ft.

Dry Hole -----

Abandoned -----

Date

9/11 1919

Pyke Scout

Map No. K 23 Sec. 14 Twp. 22 R. 4

Well No. 2 Clark

Mountain & Gulf Company

Contractor

SECTION PLAT

660 Ft. from N. Line

\_\_\_\_\_ Ft. from S. Line

\_\_\_\_\_ Ft. from E. Line

200 Ft. from W. Line


Location \_\_\_\_\_

Rig up \_\_\_\_\_

Drilling and Remarks:

*Rig in up*

RECORD

Cased \_\_\_\_\_ in., \_\_\_\_\_ ft.

Sand \_\_\_\_\_

Gas \_\_\_\_\_

Oil \_\_\_\_\_

Total Depth \_\_\_\_\_

PRODUCTION

1st 24 hrs. Nat. \_\_\_\_\_

1st 24 hrs. after shot \_\_\_\_\_

Gas \_\_\_\_\_ Cu. Ft.

Dry Hole \_\_\_\_\_

Abandoned \_\_\_\_\_

Date

9/8 1919

*Pyle*

Scout

Map No. K 23 Sec. 14 Twp. 22 R. 4

Well No. 2 Clark

Mountain & Gulf Company  
Contractor

SECTION PLAT

660 Ft. from N. Line

----- Ft. from S. Line

----- Ft. from E. Line

200 Ft. from W. Line

o			

Location -----

Rig up -----

Drilling and Remarks:

*Spud*

RECORD

Cased ----- in., ----- ft.

Sand -----

Gas -----

Oil -----

Total Depth -----

PRODUCTION

1st 24 hrs. Nat. -----

1st 24 hrs. after shot -----

Gas ----- Cu. Ft.

Dry Hole -----

Abandoned -----

Date

9/15 1919

**Pyle**

Scout

Map No. K23 Sec. 14 Twp. 22 R. 4

Well No. 2 Clark  
Mountain & Gulf Company

Contractor \_\_\_\_\_

SECTION PLAT

660 Ft. from N. Line  
 \_\_\_\_\_ Ft. from S. Line  
 \_\_\_\_\_ Ft. from E. Line  
200 Ft. from W. Line

o			

Location \_\_\_\_\_  
 Rig up \_\_\_\_\_  
 Drilling and Remarks:

*Spud &  
 N.D.*

RECORD

Cased \_\_\_\_\_ in., \_\_\_\_\_ ft.  
 Sand \_\_\_\_\_  
 Gas \_\_\_\_\_  
 Oil \_\_\_\_\_  
 Total Depth \_\_\_\_\_

PRODUCTION

1st 24 hrs. Nat. \_\_\_\_\_  
 1st 24 hrs. after shot \_\_\_\_\_  
 Gas \_\_\_\_\_ Cu. Ft.  
 Dry Hole \_\_\_\_\_  
 Abandoned \_\_\_\_\_

Date 1/22 1919

**Pyle** Scout

Map No. K23 Sec. 14 Twp. 22 R. 4

Well No. 2 Clark

Mountain Hill Company

Contractor

SECTION PLAT

660 Ft. from N. Line

\_\_\_\_\_ Ft. from S. Line

\_\_\_\_\_ Ft. from E. Line

200 Ft. from W. Line

o			

Location \_\_\_\_\_

Rig up \_\_\_\_\_

Drilling and Remarks:

*Spud &  
D.D.*

RECORD

Cased \_\_\_\_\_ in., \_\_\_\_\_ ft.

Sand \_\_\_\_\_

Gas \_\_\_\_\_

Oil \_\_\_\_\_

Total Depth \_\_\_\_\_

PRODUCTION

1st 24 hrs. Nat. \_\_\_\_\_

1st 24 hrs. after shot \_\_\_\_\_

Gas \_\_\_\_\_ Cu. Ft.

Dry Hole \_\_\_\_\_

Abandoned \_\_\_\_\_

Date

9/29 1919

**Pyle**

Scout

Map No. K 23 Sec. 14 Twp. 22 R. 4

Well No. 2 Clark

Mountain & Gulf Company

Contractor

SECTION PLAT

660 Ft. from N. Line

----- Ft. from S. Line

----- Ft. from E. Line

200 Ft. from W. Line

o			

Location -----

Rig up -----

Drilling and Remarks:

*Spud +  
D.O.*

RECORD

Cased ----- in., ----- ft.

Sand -----

Gas -----

Oil -----

Total Depth -----

PRODUCTION

1st 24 hrs. Nat. -----

1st 24 hrs. after shot -----

Gas ----- Cu. Ft.

Dry Hole -----

Abandoned -----

Date

10/6 1919

**Pyle**

Scout

Map No. K 23 Sec. 14 Twp. 22 R. 4

Well No. 2 Clark

Mountain Fuel Company

Contractor

SECTION PLAT

660 Ft. from N. Line

\_\_\_\_\_ Ft. from S. Line

\_\_\_\_\_ Ft. from E. Line

200 Ft. from W. Line

0			

Location \_\_\_\_\_

Rig up \_\_\_\_\_

Drilling and Remarks:

Spuds + S.D.

RECORD

Cased \_\_\_\_\_ in., \_\_\_\_\_ ft.

Sand \_\_\_\_\_

Gas \_\_\_\_\_

Oil \_\_\_\_\_

Total Depth \_\_\_\_\_

PRODUCTION

1st 24 hrs. Nat. \_\_\_\_\_

1st 24 hrs. after shot \_\_\_\_\_

Gas \_\_\_\_\_ Cu. Ft.

Dry Hole \_\_\_\_\_

Abandoned \_\_\_\_\_

Date

10/13 1919

**Pyle**

Scout

Map No. K 23 Sec. 14 Twp. 22 R. 4

Well No. 2 Clark

Mountain & Gulf Company

Contractor

SECTION PLAT

660 Ft. from N. Line

\_\_\_\_\_ Ft. from S. Line

\_\_\_\_\_ Ft. from E. Line

200 Ft. from W. Line

0			

Location \_\_\_\_\_

Rig up

Drilling and Remarks:

RECORD

Cased \_\_\_\_\_ in., \_\_\_\_\_ ft.

Sand \_\_\_\_\_

Gas \_\_\_\_\_

Oil \_\_\_\_\_

Total Depth \_\_\_\_\_

PRODUCTION

1st 24 hrs. Nat. \_\_\_\_\_

1st 24 hrs. after shot \_\_\_\_\_

Gas \_\_\_\_\_ Cu. Ft.

Dry Hole \_\_\_\_\_

Abandoned \_\_\_\_\_

Date

10/20 1919

**Pyle**

Scout

Map No. K 23 Sec. 14 Twp. 22 R. 4

Well No. 2 Clark

Mountain & Gulf Company

Contractor

SECTION PLAT

660 Ft. from N. Line

\_\_\_\_\_ Ft. from S. Line

\_\_\_\_\_ Ft. from E. Line

200 Ft. from W. Line


COMPLETED

Location \_\_\_\_\_

Rig up \_\_\_\_\_

Drilling and Remarks:

RECORD

Cased \_\_\_\_\_ in., \_\_\_\_\_ ft.

Sand 2539-45

Gas \_\_\_\_\_

Oil \_\_\_\_\_

Total Depth \_\_\_\_\_

PRODUCTION

1st 24 hrs. Nat. 400 bbls

1st 24 hrs. after shot \_\_\_\_\_

Gas \_\_\_\_\_ Cu. Ft.

Dry Hole \_\_\_\_\_

Abandoned \_\_\_\_\_

Date

3/8 1910

Pyle

Scout