


Map No. _____ Sec. 14 Twp. 22 R. 11

Well No. 1 FLOMAN Farm _____ Company _____
Empire

NORTH

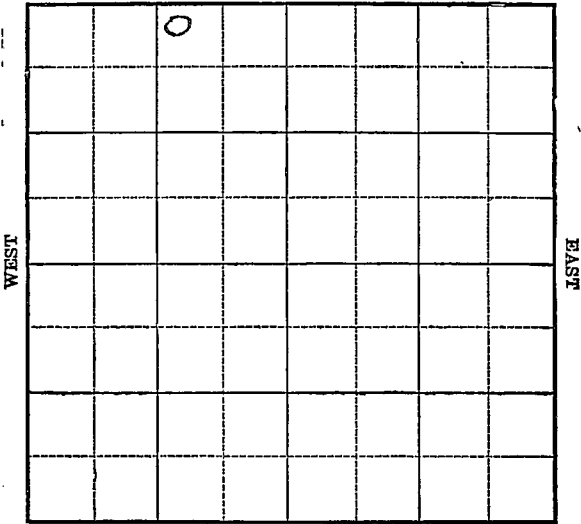

SOUTH

3

Location _____

Rig up _____

Drilling Remarks:

Drilling Remarks:

RECORD

PRODUCTION

Cased _____ in. _____ ft.

Sand _____

Gas _____

Oil _____

Total Depth _____

1st 24 hrs Nat. _____

1st 24 hrs. after shot _____

Gas _____ cu. ft.

Dry Hole _____

Abandoned _____

Map No. _____ Sec. 14 Twp. 22 R. 11

Well No. 1 Farm _____


Empire Company

200 Ft. from N. Line

_____ Ft. from S. Line

1120 Ft. from E. Line

_____ Ft. from W. Line

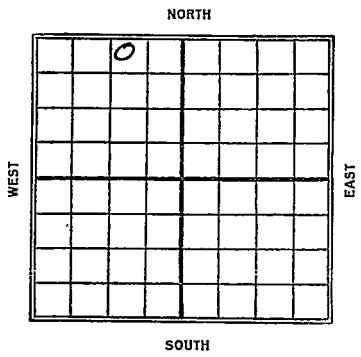

Date	REPORT
1923	
1/12	Dr. 980'
3/2	Sand 1823-52 - Shot
	100ft. 40 Bbls. I.D. 1852'

KANSAS 21

Map No. _____ Sec. 14 Twp. 22 N R. 11

Well No. _____

Empire Company

Contractor _____

FIRST REPORT

SECTION PLAT

200 Ft. from N. Line

_____ Ft. from S. Line

1120 Ft. from E. Line

_____ Ft. from W. Line

	0		

Location _____

Rig up _____

Drilling and Remarks:

10 1/2 980'

RECORD

Cased _____ in., _____ ft.

Sand _____

Gas _____

Oil _____

Total Depth _____

PRODUCTION

1st 24 hrs. Nat. _____

1st 24 hrs. after shot _____

Gas _____ Cu. Ft.

Dry Hole _____

Abandoned _____

Date **JAN 12 1923**

_____ 191 _____

M. A. BENEAR

Scout

Map No. **KANSAS** 21 Sec. 14 Twp. 32 R. 11

Well No. 1 *Fraun*

Empire Gas Co Company

Contractor

COMPLETED SECTION PLAT

200 Ft. from N. Line

_____ Ft. from S. Line

1120 Ft. from E. Line

_____ Ft. from W. Line

	0		

Location _____

Rig up _____

Drilling and Remarks:

shot logs to 40 fms.

RECORD

Cased _____ in., _____ ft.

Sand _____

Gas _____

Oil *1825-1852*

Total Depth *1852*

PRODUCTION

1st 24 hrs. Nat. _____

1st 24 hrs. after shot _____

Gas _____ Cu. Ft.

Dry Hole _____

Abandoned _____

Date

MAR 2 1923

M. A. BENEAR

Scout

Map No. **KANSAS** 21 Sec. **14** Twp. **22** R. **11**

Well No. **1 Freeman**

Empire Company

This well was drilled deeper & shot. Contractor

SECTION PLAT

330 Ft. from N. Line **COMPLETED**

_____ Ft. from S. Line

990 Ft. from E. Line

_____ Ft. from W. Line

COMPLETED

0		

Location _____

Rig up _____

Drilling and Remarks:

*sand, 11823
11850
shale 50-52
sand 1852-76
112 lbs / 104 lbs
shot 100 / 200 lbs*

Cased _____ in., _____ ft.

Sand _____

Gas _____

Oil _____

Total Depth _____

PRODUCTION

1st 24 hrs. Nat. _____

1st 24 hrs. after shot _____

Gas _____ Cu. Ft.

Dry Hole _____

Abandoned _____

Date

MAR 22 1923

192

Scout

RETURNED FOR DESTRUCTION
BENEAR

This well reported in
 the N.W. which
 is correct.

This Location is
 correct

M.P.

ft from N line
 ft from S line
 ft from E line
 ft from W line

Location	
Big up	
Drilling and Rentals	
Returned	
Cards	<i>M.P.</i>
Tracing	<i>Jm</i>
J. S. C. Card	
Plans and	<i>M.P.</i>
Moody	
Moody plat book	