


Map No. 15 Sec. 14 Twp. 22 R. 11Well No. 2 Dinky FarmEmpire Company

NORTH

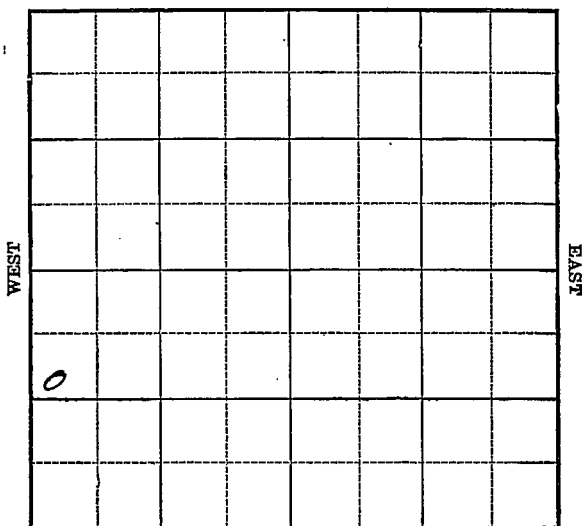

SOUTH

12

Location _____

Drilling Remarks:

Rig up _____

Drilling Remarks:

RECORD

Cased _____ in. _____ ft.

Sand _____

Gas _____

Oil _____

Total Depth _____

PRODUCTION

1st 24 hrs Nat. _____

1st 24 hrs. after shot _____

Gas _____ cu. ft.


Dry Hole _____

Abandoned _____

Map No. 71 Sec. 14 Twp. 22 R. 11Well No. 2 Herby FarmEmpire Company990 Ft. from N. Line

_____ Ft. from S. Line

_____ Ft. from E. Line

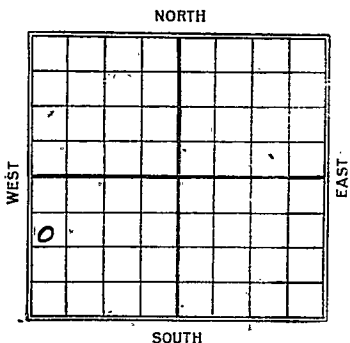330 Ft. from W. LineDate 1924 REPORT6/18 Location7/16 _____11/26 _____1925 _____1/21 _____3/30 Sand 1883-1939 P.B. to 1937

Shot 95 gals Swabbing 155

Oil 87 Bbls Water

21 KANSAS
 Map No. _____ Sec. 14 Twp. 22 R. 11
 Well No. 22 Lindsey
 Company _____ Contractor _____

FIRST REPORT

SECTION PLAT

990 Ft. from N. Line

_____ Ft. from S. Line

_____ Ft. from E. Line

330 Ft. from W. Line

Location _____

Rig up _____

Drilling and Remarks:

RECORD

Cased _____ in., _____ ft.

Sand _____

Gas _____

Oil _____

Total Depth _____

PRODUCTION

1st 24 hrs. Nat. _____

1st 24 hrs. after shot _____

Gas _____ Cu. Ft.

Dry Hole _____

Abandoned _____

Date

JUN 18 1924

M. A. BENEAR

192

Scout

21 **KANSAS** Map No. Sec. 14 Twp. 22 R. 11

Well No. 2 Lucky
Empire Oil & Gas Co. Company

Contractor

COMPLETED SECTION PLAT

990' Ft. from N. Line

----- Ft. from S. Line

----- Ft. from E. Line

330' Ft. from W. Line

Location -----

Rig up -----

Drilling and Remarks:

Plug back 1937

about 95 gals.

swabbing 155 gal

87 Water.

RECORD

Cased in, ft.

Sand 1883-1939

Gas

Oil 7.0, 190 to

Total Depth 1939

PRODUCTION

1st 24 hrs. Nat.

1st 24 hrs. after shot

Gas Cu. Ft.

Dry-Hole

Abandoned

Date

3/30 1925

M. A. BENEAR

Scout