


Map No. 14 Sec. 14 Twp. 22 R. 11
 Well No. 9 Fromm Farm
Empire O. & F. Company

NORTH

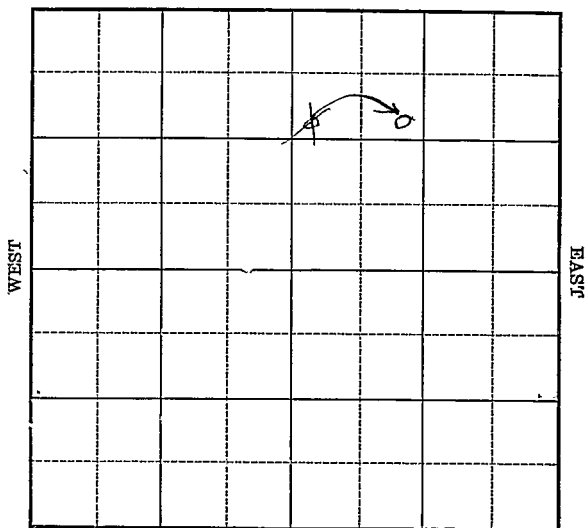

SOUTH

2

Location _____

Drilling Remarks _____

Rig Up _____

Drilling Remarks _____

RECORD

Cased _____ in. _____ ft.

Sand _____

Gas _____

Oil _____

Total Depth _____

PRODUCTION

1st 24 hrs. Nat. _____

1st 24 hrs. after shot _____

Gas _____ cu. ft.

Dry Hole _____

Abandoned _____

KANSAS

Well No. 9 Tramm Farm

Well No. 9 Fromm Farm
Empire Dr & F Company
 NORTH

NORTH

790 Ft. from N. Line

Ft. from S. Line

Ft. from E. Line

 Ft. from W. Line



EAST

SOUTH

Date _____

REPORT

2/24	Bldg Rig	
3/5	Rig	
3/10	Rigging up.	
3/18	Dlg 600	
3/25	" 1600	
3/31	Land 1861-1916	150 gts
	125 bbls	

Greenwood Co
 1121 KANSAS Sec. *14* Twp. *22* R. *11*

Well No. *9*

From
Empire Oil & Gas Co Company

Contractor

FIRST REPORTS

SECTION PLAT

990

Ft. from N. Line

Ft. from S. Line

Ft. from E. Line

330

Ft. from W. Line

		0	

Location

Rig up

Drilling and Remarks:

RECORD

Cased _____ in., _____ ft.

Sand _____

Gas _____

Oil _____

Total Depth _____

PRODUCTION

1st 24 hrs. Nat. _____

1st 24 hrs. after shot _____

Gas _____ Cu. Ft.

Dry Hole _____

Abandoned _____

Date

FEB 24 1926

192

CHAS. L. SHERWOOD

Scout

K21 KANSAS

Map No. _____ Sec. 14 Twp. 22 R. 11

Well No. 9 From _____

Empire G & F Company

Contractor _____

SECTION PLAT

990 Ft. from N. Line

_____ Ft. from S. Line

_____ Ft. from E. Line

990 Ft. from W. Line

		0.6	

CORRECTION

Location _____

Rig up ☒

Drilling and Remarks:

Change
location
to above

RECORD

Cased _____ in., _____ ft.

Sand _____

Gas _____

Oil _____

Total Depth _____

PRODUCTION

1st 24 hrs. Nat. _____

1st 24 hrs. after shot _____

Gas _____ Cu. Ft.

Dry Hole _____

Abandoned _____

Date

MAR 5 1926 CHAS. L. SHERWOOD

192

Scout

K21 Map No. **KANSAS** Sec. *14* Twp. *22* R. *11*

Well No. *9* *From*
Empire Oil Co Company

Contractor

COMPLETED

SECTION PLAT

990 Ft. from N. Line

_____ Ft. from S. Line

_____ Ft. from E. Line

990 Ft. from W. Line

		0	

Location _____

Rig up _____

Drilling and Remarks:

150, 125 BB.

RECORD

Cased _____ in., _____ ft.

Sand *1861-1916'*

Gas _____

Oil _____

Total Depth *1916'*

PRODUCTION

1st 24 hrs. Nat. _____

1st 24 hrs. after shot _____

Gas _____ Cu. Ft.

Dry Hole _____

Abandoned _____

Date

MAR 31 1926

CHAS. L. SHERWOOD

192

Scout