


Greenwood ✓

Map No. 17A Sec. 14 Twp. 22 R. 11Well No. 11 From FarmEmpire G. & A Company

NORTH

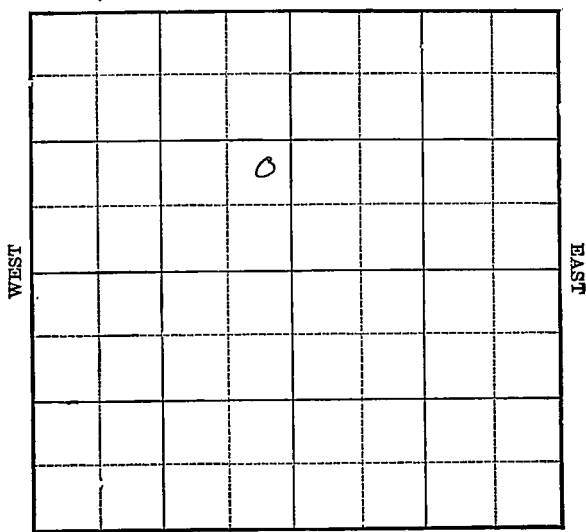

SOUTH

O. W. D. D

6

Location _____

Drilling Remarks _____

Rig Up _____

Drilling Remarks _____

RECORD

Cased _____ in. _____ ft.

Sand _____

Gas _____

Oil _____

Total Depth _____

PRODUCTION

1st 24 hrs. Nat. _____

1st 24 hrs. after shot _____

Gas _____ cu. ft.

Dry Hole _____

Abandoned _____


Map No. Kansas Sec. 14 Twp. 22 R. 11Well No. 11 Fromm FarmEmpire Gas & F Company

NORTH

_____ Ft. from N. Line

990 Ft. from S. Line330 Ft. from E. Line

_____ Ft. from W. Line

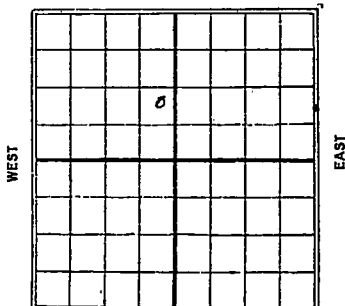

O.W. D.D.

Date

REPORT

1926

7/7 R.O.G.

7/15 Rig

7/22 Rigging up

7/28 Dlg 510

8/11 Sand 1876-1904

130/15 obble.

T.D. 1904.

1933 O.W. D.D.

4/5 Rigging up to deepen

4/12

4/19 sand 1876-1904 T.D. 1940 shot

40 ft to 1905-37- No Test

4/26 sand 1876-1904 T.D.

shot 40 ft to 1905-37 pump

45 bbl oil 52 bbl water

24 hrs

Sherwood

K21 KANSAS
 Map No. _____ Sec. 14 Twp. 22 R. 11
 Well No. 11 Brown
 Empire Gas & Fuel Co. Company

Contractor

FIRST REPORTS

SECTION PLAT

_____ Ft. from N. Line

990
_____ Ft. from S. Line330
_____ Ft. from E. Line

_____ Ft. from W. Line

	o		

Location _____

Rig up _____

Drilling and Remarks:

Robt

RECORD

Cased _____ in., _____ ft.

Sand _____

Gas _____

Oil _____

Total Depth _____

PRODUCTION

1st 24 hrs. Nat. _____

1st 24 hrs. after shot _____

Gas _____ Cu. Ft.

Dry Hole _____

Abandoned _____

Date

JUL 9 1926

192

CHAS. L. SHERWOOD

Scout

21 *Steenwood*
 Map No. **KANSAS** Sec. *14* Twp. *22* R. *11*
 Well No. *11 I Home*
Leppill 5072 Co

Company

Contractor

COMPLETED

SECTION PLAT

Ft. from N. Line

990 Ft. from S. Line

230 Ft. from E. Line

Ft. from W. Line

	0		

Location

Rig up

Drilling and Remarks:

RECORD

Cased *18 1/2* in., ft.Sand *1876-1904*

Gas

Oil

Total Depth *1904*

PRODUCTION

1st 24 hrs. Nat. _____

1st 24 hrs. after shot. _____

Gas _____ Cu. Ft.

Dry Hole _____

Abandoned _____

Date

AUG 11 1926

CHAS. L. SHERWOOD

102

Scout

Greenwood

21 KANSAS

Map No. Sec. 14 Twp. 22 R. 11

Well No. 11 "A" Fromm

Empire Oil & Refg Co Company

Contractor

FIRST REPORTS

Ft. from N. Line

990 Ft. from S. Line

330 Ft. from E. Line

Ft. from W. Line

SECTION PLAT

Location

Rig up

Drilling and Remarks: Rigging up

to Deepen

RECORD

Cased in., ft.

Sand 1876-1904

Gas

Oil

Total Depth 1904

PRODUCTION

1st 24 hrs. Nat.

1st 24 hrs. after shot

Gas Cu. Ft.

Dry Hole

Abandoned

Date

APR 5 1933 CHAS. L. SHERWOOD

192 Scout

Greenwood

F

21 KANSAS

Map No. _____ Sec. 14 Twp. 22 R. 11

Well No. 11 "9" Fromm

Empire Oil & R Co Company

Contractor

COMPLETED

SECTION PLAT

	0		

_____ Ft. from N. Line

990 Ft. from S. Line

330 Ft. from E. Line

_____ Ft. from W. Line

Location _____

Rig up _____

Drilling and Remarks:

Shot 40/1905-37

Pump 45 Blos

Oils 52 Blos

Water

RECORD

Cased _____ in., _____ ft.

Sand 1876-1904

Gas _____

Oil _____

Total Depth 1940

PRODUCTION

1st 24 hrs. Nat. _____

1st 24 hrs. after shot _____

Gas _____ Cu. Ft.

Dry Hole _____

Abandoned _____

Date

APR 23 1923

192

CHAS. L. SHERWOOD

Scout