



*Greenwood*

Map No. *1* Sec. *14* Twp. *22* R. *11*


Well No. *12* *Fromm* Farm  
*Empire Gas & Fuel* Company

..... Ft. from N. Line

*990* Ft. from S. Line

*330* Ft. from E. Line

..... Ft. from W. Line

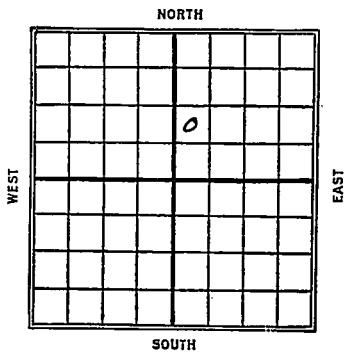

*1926*

Date

REPORT

<i>7/14</i>	<i>Location</i>
<i>7/22</i>	<i>Rig</i>
<i>7/28</i>	<i>—</i>
<i>8/4</i>	<i>Dlg 495'</i>
<i>8/11</i>	<i>" 1500</i>
<i>8/18</i>	<i>Sand 1883-1914'; shot 140 gts, 500' fluid in hole</i>
<i>8/25</i>	<i>Sand 1883-1914 140/100 lbs. T.D. 1914 feet</i>

*Sherwood*

Map No. K21 KANSAS Sec. 14 Twp. 22 R. 11

Well No. 12 *From*

*Empire Gas & Fuel Co* Company

Contractor

**FIRST REPORTS**

**SECTION PLAT**

\_\_\_\_\_ Ft. from N. Line

990 Ft. from S. Line

\_\_\_\_\_ Ft. from E. Line

330 Ft. from W. Line

		o	

Location  \_\_\_\_\_  
 Rig up \_\_\_\_\_  
 Drilling and Remarks:

**RECORD**

Cased \_\_\_\_\_ in., \_\_\_\_\_ ft.  
 Sand \_\_\_\_\_  
 Gas \_\_\_\_\_  
 Oil \_\_\_\_\_  
 Total Depth \_\_\_\_\_

**PRODUCTION**

1st 24 hrs. Nat. \_\_\_\_\_  
 1st 24 hrs. after shot \_\_\_\_\_  
 Gas \_\_\_\_\_ Cu. Ft.  
 Dry Hole \_\_\_\_\_  
 Abandoned \_\_\_\_\_

Date

**JUL 14 1926**

**CHAS. L. SHERWOOD**

192 Scout

*Sherwood*

Map No. **K2 KANSAS** Sec. **14** Twp. **22** R. **11**

Well No. **12** *Fromm*  
*Empire Gas & Fuel* Company

Contractor

**CORRECTION**

Ft. from N. Line

*990*

Ft. from S. Line

Ft. from E. Line

*330*

Ft. from W. Line

**SECTION PLAT**

		<i>OK</i>	

Location -----

Rig up -----

Drilling and Remarks:

*Chy Location to show.*

**RECORD**

Cased ----- in., ----- ft.

Sand -----

Gas -----

Oil -----

Total Depth -----

**PRODUCTION**

1st 24 hrs. Nat. -----

1st 24 hrs. after shot -----

Gas ----- Cu. Ft.

Dry Hole -----

Abandoned -----

Date

**JUL 21 1926**

**CHAS. L. SHERWOOD**  
Scout.

*Sherwood*

**21 KANSAS**

Map No. \_\_\_\_\_ Sec. 14 Twp. 22 R. 11

Well No. 12 *From*

*Em Pitt* *Gas & Fuel* Company

Contractor \_\_\_\_\_

**COMPLETED**

**SECTION PLAT**

\_\_\_\_\_ Ft. from N. Line

990 Ft. from S. Line

\_\_\_\_\_ Ft. from E. Line

330 Ft. from W. Line

		o	

Location \_\_\_\_\_

Rig up \_\_\_\_\_

Drilling and Remarks:

*140y 100 lbs*

**RECORD**

Cased 99 in., \_\_\_\_\_ ft.

Sand 1883-1914

Gas \_\_\_\_\_

Oil \_\_\_\_\_

Total Depth 1914

**PRODUCTION**

1st 24 hrs. Nat. \_\_\_\_\_

1st 24 hrs. after shot \_\_\_\_\_

Gas \_\_\_\_\_ Cu. Ft.

Dry Hole \_\_\_\_\_

Abandoned \_\_\_\_\_

Date

**AUG 25 1926**

**CHAS. L. SHERWOOD**  
Scout