


*Greenwood*

Map No. *Kant* Sec. *14* Twp. *22* R. *11*

Well No. *10* *Frogs* Farm

*Empire G. & O.* Company

NORTH

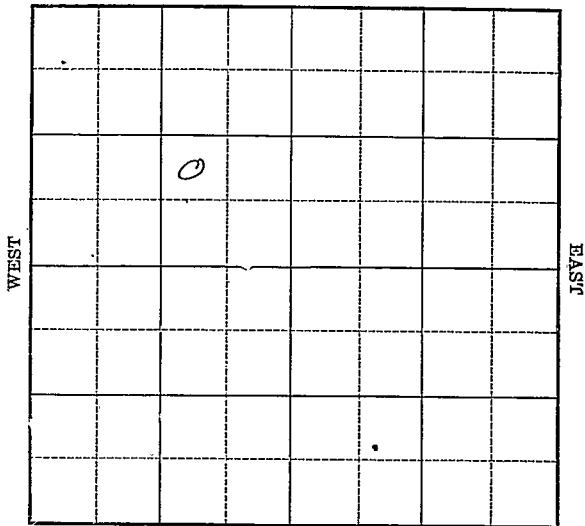

SOUTH

*6*

Location \_\_\_\_\_

Drilling Remarks \_\_\_\_\_  
\_\_\_\_\_  
\_\_\_\_\_  
Rig Up \_\_\_\_\_

Drilling Remarks \_\_\_\_\_  
\_\_\_\_\_  
\_\_\_\_\_  
**RECORD**

Cased \_\_\_\_\_ in. \_\_\_\_\_ ft.

Sand \_\_\_\_\_

Gas \_\_\_\_\_

Oil \_\_\_\_\_

Total Depth \_\_\_\_\_

**PRODUCTION**

1st 24 hrs. Nat. \_\_\_\_\_

1st 24 hrs. after shot \_\_\_\_\_

Gas \_\_\_\_\_ cu. ft.

Dry Hole \_\_\_\_\_

Abandoned \_\_\_\_\_



*Greenwood*

Map No. *K21* KANSAS Sec. *14* Twp. *22* R. *11*

Well No. *10* *Fromm*  
*Capital Oil & Co* Company

Contractor

FIRST REPORTS

SECTION PLAT

----- Ft. from N. Line  
*990* Ft. from S. Line  
*990* Ft. from E. Line  
----- Ft. from W. Line

	o		

Location -----

Rig up -----

Drilling and Remarks:

*July 200'*

RECORD

Cased ----- in., ----- ft.  
Sand -----  
Gas -----  
Oil -----  
Total Depth -----

PRODUCTION

1st 24 hrs. Nat. -----  
1st 24 hrs. after shot -----  
Gas ----- Cu. Ft.  
Dry Hole -----  
Abandoned -----

Date

JUN 24 1926

192

CHAS. L. SHERWOOD  
Scout

K21 KANSAS Map No. Sec. 14 Twp. 22 R. 11

Well No. 10 *Thomson*

*Empire Oil & Gas Co* Company

Contractor

COMPLETED

SECTION PLAT

\_\_\_\_\_ Ft. from N. Line

990 Ft. from S. Line

990 Ft. from E. Line

\_\_\_\_\_ Ft. from W. Line

	•		

Location \_\_\_\_\_

Rig up \_\_\_\_\_

Drilling and Remarks:

*1007 105 lbs.*

RECORD

Cased *18* in., \_\_\_\_\_ ft.

Sand *1877-1905*

Gas \_\_\_\_\_

Oil \_\_\_\_\_

Total Depth *1905*

PRODUCTION

1st 24 hrs. Nat. \_\_\_\_\_

1st 24 hrs. after shot \_\_\_\_\_

Gas \_\_\_\_\_ Cu. Ft.

Dry Hole \_\_\_\_\_

Abandoned \_\_\_\_\_

Date

JUL 14 1926

CHAS. L. SHERWOOD

192

Scout