


Map No. _____ Sec. 14 Twp. 22 R. 11 ✓
 Well No. 17 - Fromm Farm _____
Empire G. & F. Company

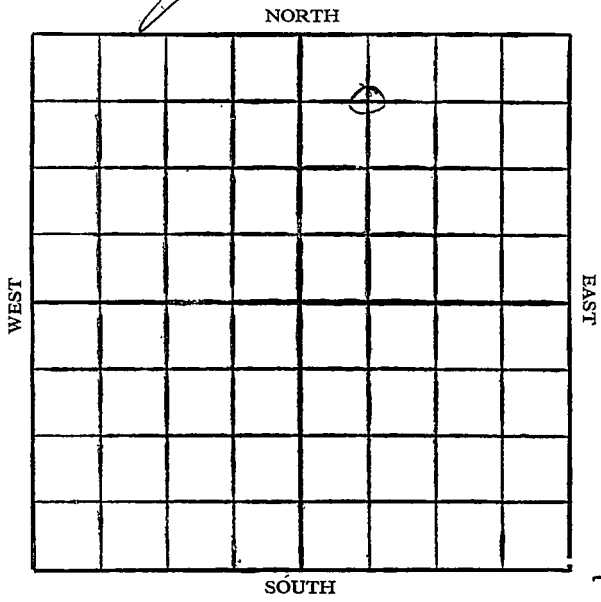

2

Location

Drilling Remarks

.....

RECORD

Cased in. ft.
 Sand
 Gas
 Oil
 Total Depth

Rig Up

Drilling Remarks

.....

PRODUCTION

1st 24 hrs. Nat.
 1st 24 hrs. after shot
 Gas cu. ft.
 Dry Hole
 Abandoned

Map No. _____ Sec. 14 Twp. 22 R. 11

Well No. 17-Froth Farm _____


Empire G. & F. Company

660 Ft. from N. Line

_____ Ft. from S. Line

_____ Ft. from E. Line

660 Ft. from W. Line

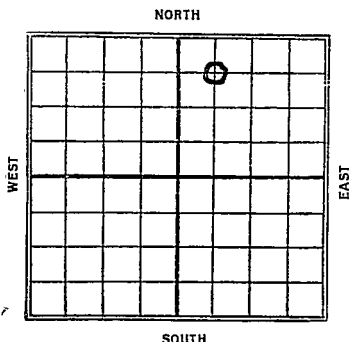

1927

Date

REPORT

6/29	Location
7/7	Bldg rig
7/13	Spud dng 150'
7/20	Drlg 1425-
7/28	" 1815
8/4	sand 1847-1890' 60' oil in hole
8/10	S.D. for orders.
8/18	S.D. may abandon Swab 2 bbls in 3 hrs
8/24	1847-1890 T.D. 1890 2 1/2 bbls natural This hole will be used for air later

21 **KANSAS** *Greenwood*
 Map No. _____ Sec. *14* Twp. *22* R. *11*
 Well No. *17* *Fromm*
Empire Oil & Gas Co Company

Contractor _____

FIRST REPORTS

SECTION PLAT

660 Ft. from N. Line

_____ Ft. from S. Line

_____ Ft. from E. Line

660 Ft. from W. Line

		o	

Location _____

Rig up _____

Drilling and Remarks:

RECORD

Cased _____ in., _____ ft.

Sand _____

Gas _____

Oil _____

Total Depth _____

PRODUCTION

1st 24 hrs. Nat. _____

1st 24 hrs. after shot _____

Gas _____ Cu. Ft.

Dry Hole _____

Abandoned _____

Date

June 19, 1927

CHAS. L. SHERWOOD
 Scout

Sherwood

K21 KANSAS

Map No. _____ Sec. *14* Twp. *22* R. *11*

Well No. *17* *Fromm*

Empire Oil Co Company

Contractor

COMPLETED

SECTION PLAT

660 Ft. from N. Line

_____ Ft. from S. Line

_____ Ft. from E. Line

660 Ft. from W. Line

		0	

Location _____

Rig up _____

Drilling and Remarks:

2 1/2" AB natural

*This hole was
dr using gas
dry later.*

RECORD

Cased _____ in., _____ ft.

Sand *1847-1890*

Gas _____

Oil _____

Total Depth *1890*

PRODUCTION

1st 24 hrs. Nat. _____

1st 24 hrs. after shot _____

Gas _____ Cu. Ft.

Dry Hole _____

Abandoned _____

Date

AUG 24 1927

CHAS. L. SHERWOOD

Scout