


Map No. A Sec. 14 Twp. 22 R. 11

Well No. 3 Hellsor Farm

Empire Company

NORTH

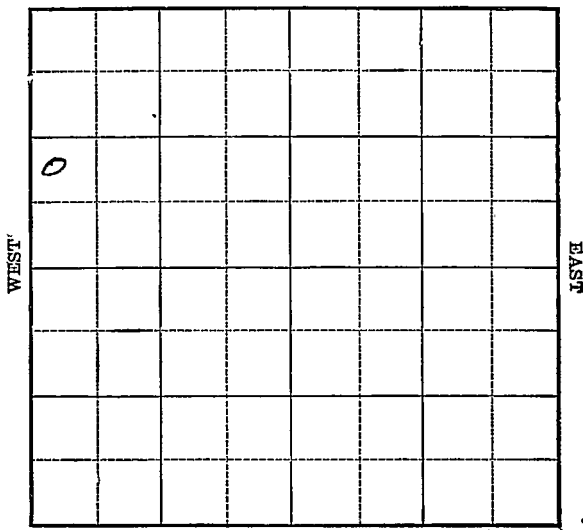

Location _____

Drilling Remarks:

RECORD

Cased _____ in. _____ ft.
 Sand _____
 Gas _____
 Oil _____
 Total Depth _____

Rig Up _____

Drilling Remarks:

PRODUCTION

1st 24 hrs. Nat. _____
 1st 24 hrs. after shot _____
 Gas _____ cu. ft.
 Dry Hole _____
 Abandoned _____

Map No. K Sec. 14 Twp. 22 R. 11


Well No. 3 Kellison Farm
Empire Company

_____ Ft. from N. Line

990 Ft. from S. Line

_____ Ft. from E. Line

330 Ft. from W. Line

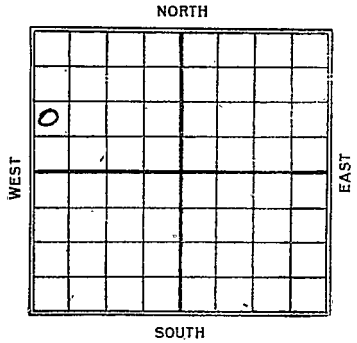

REPORT

Date

3/14 Location

4/24 Dlg 970'

5/22 Sand 1887-91-

Shale 1891-1901

Sand 1901-20

80/150 Blbs.

Map No. ~~CV-1103~~ ²¹ Sec. 14 Twp. 22 R. 11

Well No. 3 Kellison

Empire Company

Contractor

FIRST REPORT

SECTION PLAT

_____ Ft. from N. Line

990 Ft. from S. Line

_____ Ft. from E. Line

330 Ft. from W. Line

○			

Location ✓✓

Rig up _____

Drilling and Remarks:

RECORD

Cased _____ in., _____ ft.

Sand _____

Gas _____

Oil _____

Total Depth _____

PRODUCTION

1st 24 hrs. Nat. _____

1st 24 hrs. after shot _____

Gas _____ Cu. Ft.

Dry Hole _____

Abandoned _____

Date

MAR 14 1924

192

M. A. BENEAR

Scout

21
 Map No. 4343 Sec. 14 Twp. 32 R. 11

Well No. 33 Kellison

Empire Company

Contractor

COMPLETED

SECTION PLAT

_____ Ft. from N. Line

990 Ft. from S. Line

_____ Ft. from E. Line

330 Ft. from W. Line

0			

Location _____

Rig up _____

Drilling and Remarks:

sand 1887-91

shale 1891-1901

sand 1901-26

80/150 shale

RECORD

Cased _____ in., _____ ft.

Sand _____

Gas _____

Oil _____

Total Depth _____

PRODUCTION

1st 24 hrs. Nat. _____

1st 24 hrs. after shot _____

Gas _____ Cu. Ft.

Dry Hole _____

Abandoned _____

Date MAY 22 1924

M. A. BENEAR