

DX 78-1

14

22

11E

Section _____ Township _____ Range _____


Well No. #1 Sikes *(Sites)*

Company A.R. Jones & Michaelis

NORTH

WEST

EAST

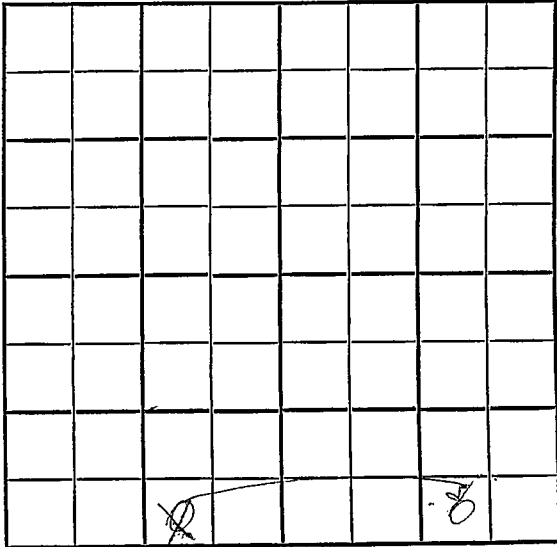

SOUTH

16

County Greenwood Elev. _____
 Sec. 14 Twp. 22 Rgs. 11E
 Company A. B. Jones & Michaelis
 Farm Name Sikes No. 1

TOPS	DEPTH	LOG	DATUM
Anb.			
TP			
H.			
Tr.			
Dg.			
BL.			
L.	925		
K.C.			
B.K.C.			
Ce.			
C.			
M.			
M.			
K.			
Mz.			
Me.			
V.			
S.			
S.			
A.			
R.			
PE.			
G.			
T.D.			

Loc. in Sec. _____
SW SE SW
 Geol. _____
 Contr. _____
Geneva Tools
 Pool _____
Madison

FIRST REPORT			
OCT 17 1956			

Date Commspd. 10-10-56
8" @ 22, Drlg. 1745

1956 OCT 17

R. G.

Co.

Lec.

No.

Sec.

T.

R.

CORRECTION

FORM 513 SUNRAY

Co. No. Sec. T. R.

County Greenwood Elev. _____
 Sec. 14 Twp. 22 Rgs. 11E
 Company A. R. Jones & Michaelis
 Farm Name Sikes No. 1

TOPS	DEPTH	LOG	DATUM	Loc. in Sec.
Anh.				<u>SW SE: SE SE</u>
TP.				<u>200 FWSL from</u>
H.				<u>100 FSL from</u>
Tr.				<u>E2 of SE</u>
Dg.				
BL.				
L.	<u>925</u>			
K.C.				Geol. _____
B.K.C.				Contr. _____
Ce.				<u>Geneva Tools</u>
C.	<u>Dart sd 1832</u>			
M.				Pool _____
M.				<u>Madison</u>
K.				
Mz.				
Mo.				
V.				
S.				
S.				
A.				
R.				
PE.				
G.				
TD.	<u>1859</u>			<div style="border: 1px dashed black; padding: 5px; width: fit-content; margin: auto;"> <p style="font-size: 2em; margin: 0;">COMPLETE</p> <p style="margin: 0;">OCT 24 '56</p> <p style="margin: 0;">0</p> </div>

Date Comm. spd. 10-10-56
8" @ 22, Drlg. 1745 OC. 24 '56 4 1/2 @ 1834
Co 1850 Frac P. 25 Bopdt
50 Bwpt.