


Greenwood

DX 78-1

KANSAS

Section 14 Township 22 Range 11E
 Well No. #2 Sikes *(Sites)*
 Company A.R. Jones & Michaelis

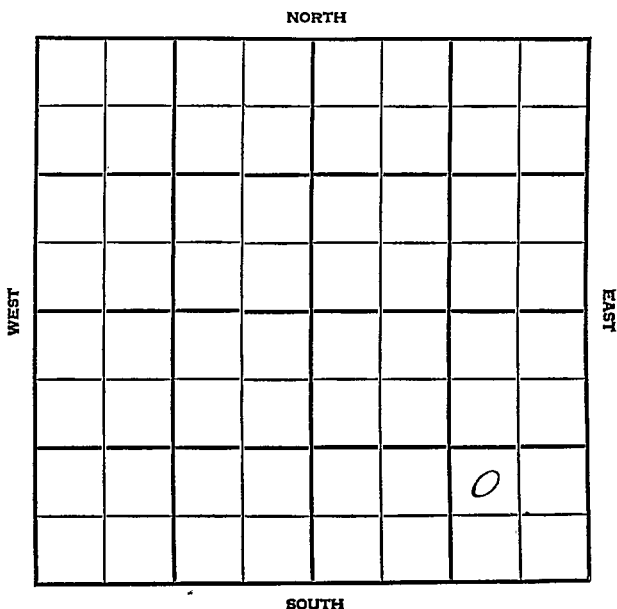

16

County Greenwood Elev.

Sec. 14 / 1 / 22 Reg. 11E

Company A. R. Jones & Michaelis

FarmName Sikes No. 2

TOPS	DEPTH	LOG	DATUM
------	-------	-----	-------

Loc. in Sec. _____
NW SE SE
200' FWLX 750'
fsl E/2 of Sec _____

Anh.

Tr.

H.

Tr. _____

Dg.

B.L.

L. —

K.C.

B.K.C.

Ce.

C. —

M. —

M. —

K. —

Mz.

Mq. 11

V. —

5

S. —
A

A -
R

1. **В. —**
 2. **Р.С.**

5

2.

FD

Geol. _____

Contr _____

Geneva Tools

Pool _____

Madison

FIRST REPORT

24 '56

Date Comm.

gn @ 66, Drlg. 1800

8701 - 5 - 3

APR 2011

County Greenwood Elev. 1190 RB
 Sec. 14 Twp. 22 Rge. 11E
 Company A. R. Jones & Michaelis
 FarmName Sikes No. 2

TOPS	DEPTH	LOG	DATUM	Loc. in Sec.
Anh.				NW SE SE
Tr.				250' MAX 75'
H.				25' E/2 of Sec
Tr.				
Dg.	800			
Bl.				
L.	940			Geol.
K.C.	1210			Contr.
R.K.C.	Bartlesh 1862			Geneva Tools
Ce.				Pool
C.				Madison
M.				
M.				
K.				
Mz.				
Mo.				
V.				
S.				
S.				
A.				
R.				
Pe.				
G.				
T.D.	1890			

ABANDONED

OCT 31 '56

Date Comm.

8" @ 66, Drlg. 1800 OCT 31 '56

DEA