


Well No. 1- Russell Farm
Carmado Pet Company

NORTH

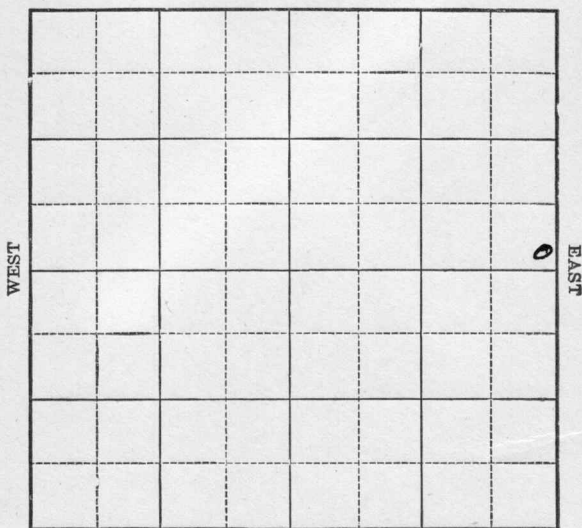

SOUTH

Location _____

Drilling Remarks:

Rig Up _____

Drilling Remarks:

RECORD

Cased _____ in. _____ ft.

Sand _____

Gas _____

Oil_____

Total Depth_____

PRODUCTION

1st 24 hrs. Nat. _____

1st 24 hrs. after shot_____


Gas _____ cu. ft.

Dry Hole _____

Abandoned _____

Map No. K Sec. 15 Twp. 22 R. 3 E
 Well No. 1 Bussele Farm
Comarado Pet Company

Ft. from N. Line
200 Ft. from S. Line
200 Ft. from E. Line
 Ft. from W. Line

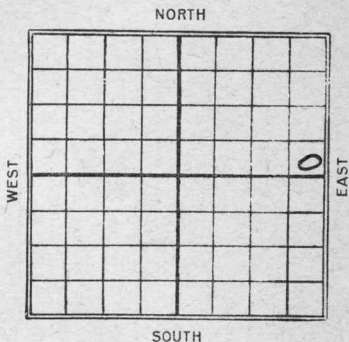

Date

REPORT

1924
4/9 Big up
4/24 Rain up
7/16 6 5/8 inch 2710 0192770'
8/26 Temp. 24 93'
20 31 9. 30 51

Map No. K 24 Sec. 15 Twp. 22 R. 3 EWell No. #1 RussellAmarula Pub Company

Contractor

FIRST REPORT

SECTION PLAT

Ft. from N. Line

300 Ft. from S. Line300 Ft. from E. Line

Ft. from W. Line

			0

Location

Rig up ✓✓

Drilling and Remarks:

RECORD

Cased _____ in., _____ ft.

Sand _____

Gas _____

Oil _____

Total Depth _____

PRODUCTION

1st 24 hrs. Nat. _____

1st 24 hrs. after shot _____

Gas _____ Cu. Ft.

Dry Hole _____

Abandoned _____

Date

APR 9 1924

192

M. A. BENEAR

Scout

24 KANSAS
 Map No. _____ Sec. 15 Twp. 22 R. 36

Well No. 1 Russell _____

Amara Petroleum Company _____

Contractor _____

ABANDONED

SECTION PLAT

_____ Ft. from N. Line

200 _____ Ft. from S. Line

200 _____ Ft. from E. Line

_____ Ft. from W. Line

Location _____

Rig up _____

Drilling and Remarks:

Tap L. 2493
 LQ+9
 3051

RECORD

Cased _____ in., _____ ft.

Sand _____

Gas _____

Oil _____

Total Depth _____

PRODUCTION

1st 24 hrs. Nat. _____

1st 24 hrs. after shot _____

Gas _____ Cu. Ft.

Dry Hole _____

Abandoned _____

Date

AUG 26 1924

192

W. M. A. BENDER

Scout

K24 ANSAS SEC. 15 TWP. 7YS R. 3E

WELL NO. 1 Russell

Amerada Pet COMPANY

CONTRACTOR

SECTION PLAT

ABANDONED

_____ FT. FROM N. LINE

_____ FT. FROM S. LINE

_____ FT. FROM E. LINE

_____ FT. FROM W. LINE

checks will
over wall map

			0

RECORD

LOCATION _____

CASED _____ IN., _____ FT.

RIG UP _____

SAND _____

DRILLING AND REMARKS:

GAS _____

OIL _____

TOTAL DEPTH 3057

PRODUCTION

1ST 24 HRS. NAT. _____

1ST 24 HRS. AFTER SHOT _____

GAS _____ Cu. Ft.

DRY HOLE ☒

ABANDONED ☒

DATE

8/13 ✓

192

SCOUT