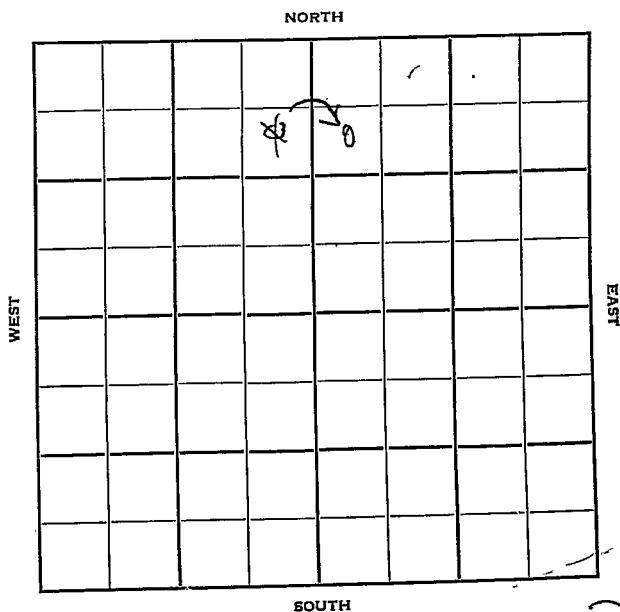


Section 15 Township 22 Range 4EWell No. #1 BurtonCompany W. R. Justice

Marion

KANSAS

Sec. 15 Twp. 22 R. 4 E

Well No. # 1 Burton Farm

W. R. Justice Company

Uhl Drlg. Contractor


800 Ft. from N. Line

 Ft. from S. Line

330 Ft. from E. Line

 Ft. from W. Line

~~SE NE NW~~ (old well abd
~~SW NW NE~~

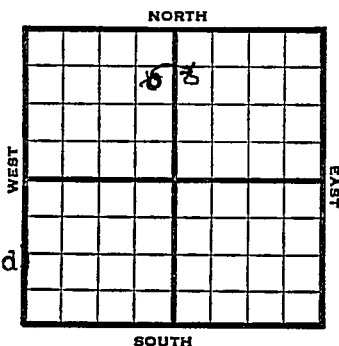

1952 Elev. - REPORT

6/4 Spud 5-27-52
8" @ 103' KC 1875'
DST 1875-90 open 1 hr. rec 175' mud &
water, 60' muddy SW
Drlg. 2127'

6/11 Spud 5-27-52 D&A TD 2725'
8" @ 103' KC 1872
DST 1875-90 open 1 hr. rec. 175'
mud & wtr. 60 muddy Sw
Miss 2381 Kh. 2404
Misener 2531
DST 2532-41 open $\frac{1}{2}$ hr. rec. 240'
mud & wtr. 1740' sul. wtr.
Hunton 2534
DST 2551-58 open $\frac{1}{2}$ hr. rec. 1922'
sul. wtr. & SS0
Viola 2585'
DST 2589-96 open 20 min. rec. 1788'
sw Simp. 2673 Arb. 2712-25 TD
D&A

ABANDONED



0

FIRST REPORT

Drlg. Data				
8" @ 103	KC 1875	DST 1875-90	open 1 hr	
Rec. 175'	mud & water	60'	muddy sw	
drlg. 2127				

J. G. McGEHEE

KansasMap No. _____ Sec. 15 Twp. 22 R. 4EWell No. 1 Burton

W. R. Justice _____ Company

CORRECTION _____ Contractor

SW NW NE

SECTION PLAT

		o	

800 Ft. from N. Line

_____ Ft. from S. Line

_____ Ft. from E. Line

160 Ft. from W. LineMarion County

Location _____

Rig up _____

Drilling and Remarks:

Reported

SE NE NW

RECORD

Cased _____ in., _____ ft.

Sand _____

Gas _____

Oil _____

Total Depth _____

PRODUCTION

1st 24 hrs. Nat. _____

1st 24 hrs. after shot _____

Gas _____ Cu. Ft.


Dry Hole _____

Abandoned _____

Date

J. G. McGEHEEJUN 11. 1952 19 _____ Scout

County Marion State Kansas
 Sec. 15 (Blk. 22 (Sur. 4E Map No.
 (Twp.) (Rge.)
 Operator W. R. Justice
 Well No. 1 Farm Burton
 Elev. Location SW NW NE

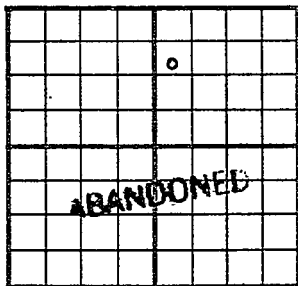

800 Ft. From N Line NE
 160 Ft. From W Line Quarter
 Ist. Report
 Completion JUN 11 1952
 Remarks
Uhl Drlg. - Contr.
 Spudding Date 5-27-52

Drlg. Data D & A TD 2725
8" @ 103 KC 1872 DST 1875-90
open 1 hr. Rec. 175' mud & water
60' muddy sw Miss. 2381 Kh. 2404
Misener 2531 DST 2532-41 open $\frac{1}{2}$ hr.
Rec. 240' mud & water 1740' sul. water
Hunton 2534 DST 2551-58 open $\frac{1}{2}$ hr.
Rec. 1922' sul. water & SSO Viola 2585
DST 2589-96 open 20 min. Rec. 1788' sw
Simp. 2673 Arb. 2712-25 TD

D & A

J. G. McGEHEE