


Section 15 Township 22 Range 4E

Well No. 16 Alvin


Company Phillips

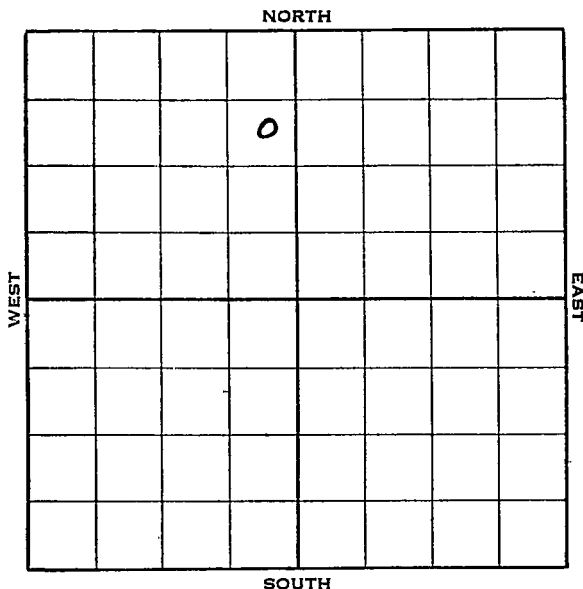

3

Sec. 15 Twp. 22 R. 4-EWell No. #16 Alvin FarmPhillips Company880 Ft. from N. Line Ft. from S. Line440 Ft. from E. Line Ft. from W. Line

Elev. 1480

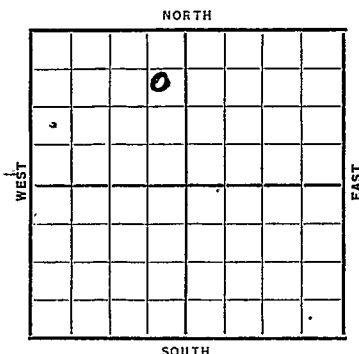

Date	REPORT
1938	
8/3	Machine.
8/12	Spud.
8/19	15" - 60'. Dlg. 860'.
8/26	12" - 913'. Rng. - 10" p 1780'.
9/2	10" - 1780'. Lans. 1852'.
	S. O. 1852-59'. T. D. 2271'.
	Rng. 8".
9/9	8" - 2487'.
9/16	T. D. 2489' C. O.
9/23	Miss. 2488'. T. D. 2489'.
	1800' water & S. S. O.
	C. O.
9/30	" " "
10/7	R. U. to deepen.
10/14	S. L. M. 2489 equals 2503'.
	Hunton 2507'. T. D. 2511'.
	850' oil & 1250' water from
	Miss. Swab 14 oil & 201 wtr.
10/21	Testing.
10/28	1000 acid. Pump 100 oil & 2290
	water in 24 hrs.

OVER

1938

11/2

8" - 2487'.

Hunton 2507'.

T. D. 2511'.

1000 acid.

94 oil & 2300 water per day.

COMPLETED

Marion

KANSAS

Map No. 23 Sec. 15 Twp. 22 R. 4EWell No. 16 AlvinPhillips

Company

Contractor

FIRST REPORT

SE NE NW

880 Ft. from N. Line

_____ Ft. from S. Line

440 Ft. from E. Line

_____ Ft. from W. Line

SECTION PLAT

	0		

Location _____

Rig up _____

Drilling and Remarks:

Mach

RECORD

Cased _____ in., _____ ft.

Sand _____

Gas _____

Oil _____

Total Depth _____

PRODUCTION

1st 24 hrs. Nat. _____

1st 24 hrs. after shot _____

Gas _____ Cu. Ft.

Dry Hole _____

Abandoned _____

Date

AUG 3 - 1938 19 H. D. Hatfield Scout

Marion **KANSAS**Map No. 23 Sec. 15 Twp. 22 R. 4EWell No. 16 AlvinPhillips

Company

Contractor

COMPLETED**SE NE NW**880 Ft. from N. Line Ft. from S. Line440 Ft. from E. Line Ft. from W. Line**SECTION PLAT**

	①		

Location Rig up

Drilling and Remarks:

1000 Acid94 oil &2300 wtrPer day**RECORD**Cased 8 in. 2487 ft.Sand HUNTON 2507Gas Oil Total Depth 2511**PRODUCTION**1st 24 hrs. Nat. 1st 24 hrs. after shot Gas Cu. Ft.Dry Hole Abandoned

Date

NOV 2 - 1938 19H. D. Hatfield

Scout