


Marion

O. W. D. D
KANSASSection 15 Township 22 Range 4EWell No. #1 ClarkCompany *Phillips*
Warren I. Winnie

NORTH

WEST

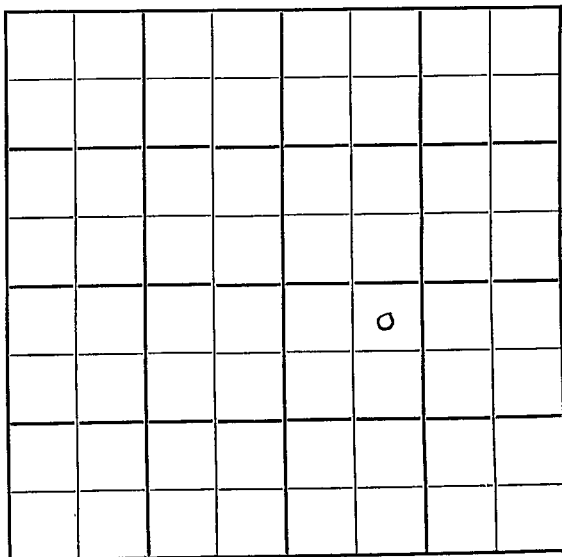

EAST

SOUTH

10

KANSAS

Marion

Sec. 15 Twp. 22 R. 4-E ✓

Well No. #1 Clark Farm

Phillips
Warren I Winnie Company

Dunn & Strait-Conte.
Eckland Drig. Contractor

Peabody


330 Ft. from N. Line

_____ Ft. from S. Line

_____ Ft. from E. Line

990 Ft. from W. Line

NE NW SE

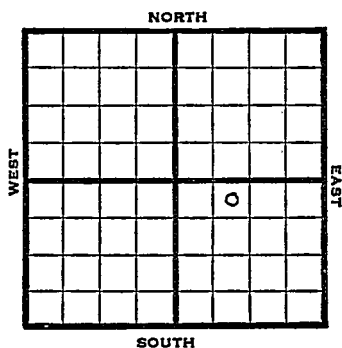


1950 Elev 1478 REPORT

10/18 Spud 10-16-50
drlg 180
11/1 8 5/8" @ 113
Miss 2400
DST 2397-2421 opn 1 1/2 hr rec 45' fluid
Viola 2538
Arb 2713
TD 2888
D&A
ABANDONED

O. W. D. D


1950
12/27 Arb. 2713'
OTD 2880
D&A
RUR to DD for SWD

1951
1/31 SWD well TD 3247
Arb. 2713
OTD 2880
Regan 3197 Granid 3239
TD 3247
5" @2720
2500 A
Comp. for SWD
ABANDONED

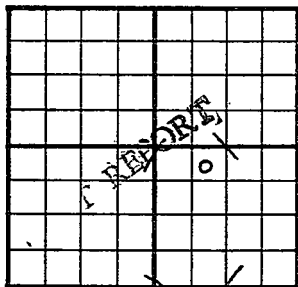County Marion State KansasSec. 15 (Blk. Twp.) 22 (Sur. Rge.) 4E Map No.Operator Warren I WinnieWell No. 1 Farm ClerkElev. Location NE NW SE330 Ft. From N Line SE990 Ft. From W Line Quarter1st. Report OCT 18 1950

Completion

Remarks old wells PluggedEckland Drlg. - Contr.Spudding Date 10-16-50Drlg. Data Peabody Pooldrlg. 180

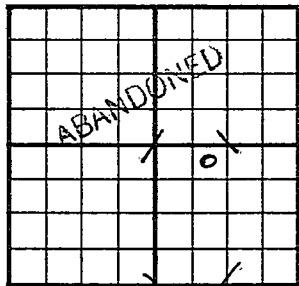County Marion State KansasSec. 15 (Blk.) 22 (Sur.) 4E Map No. (Twp.) (Rge.)Operator Warren F. WinnieWell No. 1 Farm ClarkElev. 1478 Location NE NW SE330 Ft. From N Line SE990 Ft. From W Line Quarter1st. Report NOV 1 1950Completion Remarks Peabody PoolEckland Drlr. - Contr.Spudding Date 10-16-50Drig. Data D & A TD 28888 5/8" @ 113 Miss. 2400 DST 2397-2421open 1 1/2 hr. Rec. 45' fluid Viola 2538Arb. 2713 TD 2888D & A

J. E. TYRA

R U R to DD for SWD

J. E. TYRA

J. E. TYRA