


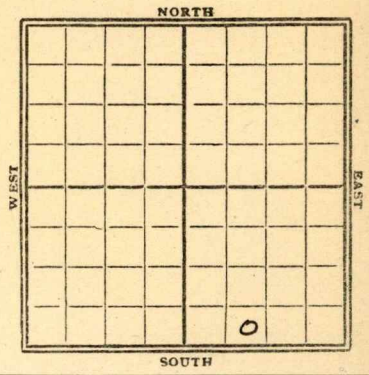

Map No. **KANSAS** Sec. 15 Twp. 22 R. 12<sup>E</sup>

Well No. 2-13 Norton Farm  
Empire O&R Company

         Ft. from N. Line  
330 Ft. from S. Line  
         Ft. from E. Line  
990 Ft. from W. Line



1929

Date REPORT

Date	REPORT
7/31	Bldy Rgy
8/17	Spdy 90'
8/14	Wdly 875'
8/21	1525
8/28	sdy shale 1718-54'
	sand 1762-68' <del>shale</del>
	show water 1763'
	sand 1793-1806'
	Top lime 1855'
	T.D. 1907
	Abandoned

*Sherwood*

Map No. **KANSAS** Sec. 15 Twp. 22 R. 12 <sup>E</sup>

Well No. 28 *Norton*

*Empire Oil & Gas*

Company

Contractor

**FIRST REPORTS**

**SECTION PLAT**

\_\_\_\_\_ Ft. from N. Line

330 Ft. from S. Line

\_\_\_\_\_ Ft. from E. Line

990 Ft. from W. Line


Location \_\_\_\_\_

Rig up \_\_\_\_\_

Drilling and Remarks:

*Block Rig*

**RECORD**

Cased \_\_\_\_\_ in., \_\_\_\_\_ ft.

Sand \_\_\_\_\_

Gas \_\_\_\_\_

Oil \_\_\_\_\_

Total Depth \_\_\_\_\_

**PRODUCTION**

1st 24 hrs. Nat. \_\_\_\_\_

1st 24 hrs. after shot \_\_\_\_\_

Gas \_\_\_\_\_ Cu. Ft.

Dry Hole \_\_\_\_\_

Abandoned \_\_\_\_\_

Date

**JUL 31 1929**

**CHAS. L. SHERWOOD**

Greenwood

21  
Map No. **KANSAS** Sec. 15 Twp. 22 R. 12

Well No. 2 B Norton

Empire Company

Contractor

**COMPLETE**

**SECTION PLAT**

			0

\_\_\_\_\_ Ft. from N. Line

330 Ft. from S. Line

\_\_\_\_\_ Ft. from E. Line

990 Ft. from W. Line

**ABANDONED**

Location \_\_\_\_\_

Rig up \_\_\_\_\_

Drilling and Remarks:

SS 1718-54  
Sand 1762-68 slow  
water 1763  
Sand 1793-1806  
Top line 1855

**RECORD**

Cased \_\_\_\_\_ in., \_\_\_\_\_ ft.

Sand \_\_\_\_\_

Gas \_\_\_\_\_

Oil \_\_\_\_\_

Total Depth 1907

**PRODUCTION**

1st 24 hrs. Nat. \_\_\_\_\_

1st 24 hrs. after shot \_\_\_\_\_

Gas \_\_\_\_\_ Cu. Ft.

Dry Hole

Abandoned

Date

**AUG 28 1929 CHAS. L. SHERWOOD**

19

Scout