

KANSAS


Greenwood ✓

Section 15 Township 22 Range 12E

Well No. 1 Schwab

Company White & Ellis

Misc.

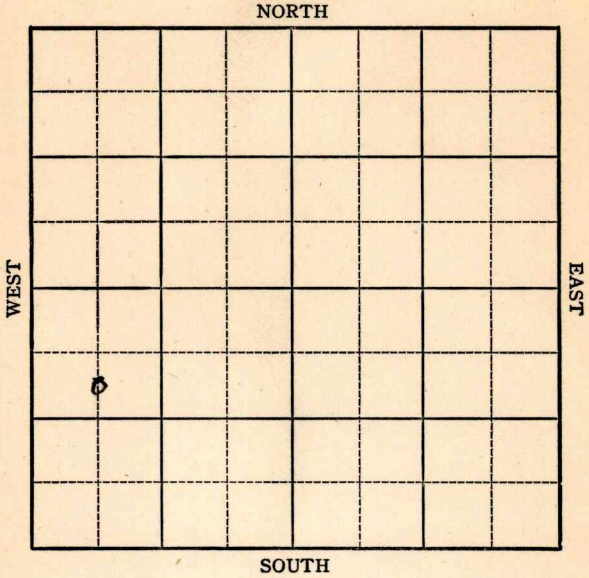

Sec. 15 Twp. 22 R. 12E ✓

Well No. #1 Schwab Farm

White & Ellis

Miscellaneous (White & Ellis, Cont.) Company


NORTH

990' Ft. from N. Line

_____ Ft. from S. Line

_____ Ft. from E. Line

660' Ft. from W. Line

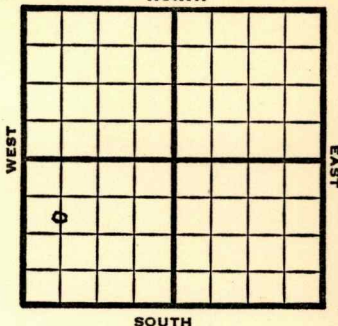

C S L NW SW

1949

REPORT

5/18 Pipe set
 5/25 "
 6/1 TD 1772'
 Bart 1721'
 5" @ 1695'
 40 qts
 Pump & Oil Pot
 38° Gr.
 Comp

COMPLETED

~~Kansas~~
Kansas

Map No. _____ Sec. 15 Twp. 22 R. 12E

Well No. 1 Schwab

White & Ellis Company

White & Ellis Contractor

C S L NW SW

**FIRST REPORT
SECTION PLAT**

990 Ft. from N. Line

_____ Ft. from S. Line

_____ Ft. from E. Line

660 Ft. from W. Line

Greenwood County

Location _____

Rig up _____

Drilling and Remarks:

Pipe set

RECORD

Cased _____ in., _____ ft.

Sand _____

Gas _____

Oil _____

Total Depth _____

PRODUCTION

1st 24 hrs. Nat. _____

1st 24 hrs. after shot _____

Gas _____ Cu. Ft.

Dry Hole _____

Abandoned _____

Date

MAY 18 1949 19

S. J. LEWIS Scout

Kansas

Map No. K21 Sec. 15 Twp. 22 R. 12E

Well No. 1 Schwab

White & Ellis Company

COMPLETE Contractor

C S L NW SW

SECTION PLAT

990 Ft. from N. Line

_____ Ft. from S. Line

_____ Ft. from E. Line

660 Ft. from W. Line

Greenwood County

Location _____

Rig up _____

Drilling and Remarks:

Box 41721
5" @ 1695
439 ft
Pump Soil PT
380 ft

RECORD

Cased _____ in., _____ ft.

Sand _____

Gas _____

Oil _____

Total Depth 1771

PRODUCTION

1st 24 hrs. Nat. _____

1st 24 hrs. after shot _____

Gas _____ Cu. Ft.

Dry Hole _____

Abandoned _____

Date

JUN 1 1949 19

S. J. LEWIS Scout