


Map No. **KANSAS** Sec. 15 Twp. 22 R. 17<sup>E</sup>

Well No. 1 - Storey Farm \_\_\_\_\_  
Theta Oil Co Company

NORTH

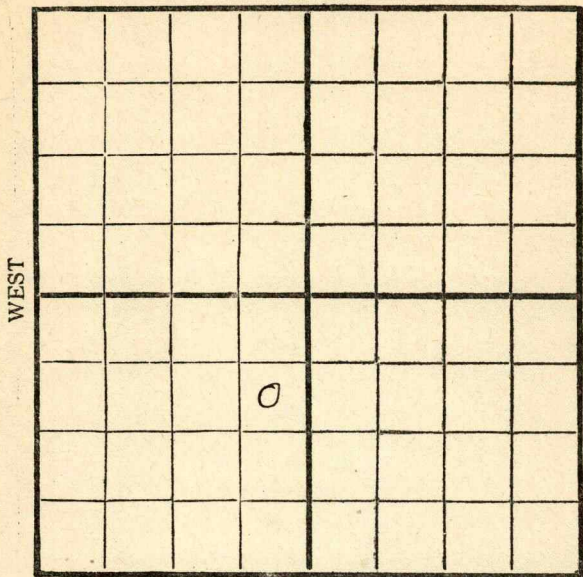

SOUTH

Location \_\_\_\_\_

Drilling Remarks \_\_\_\_\_

\_\_\_\_\_

\_\_\_\_\_

Rig Up \_\_\_\_\_

Drilling Remarks \_\_\_\_\_

\_\_\_\_\_

\_\_\_\_\_

RECORD

Cased \_\_\_\_\_ in. \_\_\_\_\_ ft.

Sand \_\_\_\_\_

Gas \_\_\_\_\_

Oil \_\_\_\_\_

Total Depth \_\_\_\_\_

PRODUCTION

1st 24 hrs. Nat. \_\_\_\_\_

1st 24 hrs. after shot \_\_\_\_\_

Gas \_\_\_\_\_ cu. ft. \_\_\_\_\_

Dry Hole \_\_\_\_\_

Abandoned \_\_\_\_\_

Greenwood

FORM 252A-5M-12-28-PETROL

Map No. **KANSAS** Sec. 15 Twp. 22 R. 12<sup>E</sup>


Well No. 1 - Hoover Farm  
Theta Oil Company

990 Ft. from N. Line

\_\_\_\_\_ Ft. from S. Line

330 Ft. from E. Line

\_\_\_\_\_ Ft. from W. Line

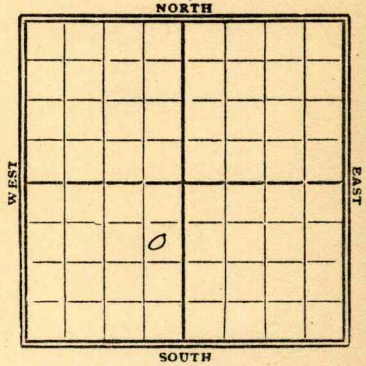

1929

Date

REPORT

Date	REPORT
8/17	Dry 400'
8/14	" 1000'
8/21	HFW 1732 - 1739
8/28	sand 1732 - 55'
	T.D. 1780' HFW
	Abandoned

Sherwood

21 Map No. **KANSAS** Sec. 15 Twp. 22 R. 12

Well No. 1 Horner  
Sheta Oil Co Company

Contractor

SECTION PLAT

		o	

**COMPLETE**

990 Ft. from N. Line

\_\_\_\_\_ Ft. from S. Line

330 Ft. from E. Line

\_\_\_\_\_ Ft. from W. Line

**ABANDONED**

Location \_\_\_\_\_

Rig up \_\_\_\_\_

Drilling and Remarks:

RECORD

Cased \_\_\_\_\_ in., \_\_\_\_\_ ft.

Sand 1737-1755

Gas \_\_\_\_\_

Oil SHW

Total Depth 1780

PRODUCTION

1st 24 hrs. Nat. \_\_\_\_\_

1st 24 hrs. after shot \_\_\_\_\_

Gas \_\_\_\_\_ Cu. Ft.

Dry Hole

Abandoned

Date

**AUG 28 1929**

**CHAS. L. SHERWOOD**

*Greenwood*

21 **KANSAS** Sec. 15 Twp. 22 R. 12 <sup>E</sup>

Well No. 1 *Storer*  
*Theta Oil Co* Company

Contractor

**FIRST REPORTS**

**SECTION PLAT**

*990* Ft. from N. Line  
Ft. from S. Line  
*330* Ft. from E. Line  
Ft. from W. Line


Location.....  
Rig up.....  
Drilling and Remarks:

*Dlg 400'*

**RECORD**

Cased.....in., .....ft.  
Sand.....  
Gas.....  
Oil.....  
Total Depth.....

**PRODUCTION**

1st 24 hrs. Nat.....  
1st 24 hrs. after shot.....  
Gas.....Cu. Ft.  
Dry Hole.....  
Abandoned.....

Date  
**AUG 7 1929**

**CHAS. L. SHERWOOD**

192.....Scout