

Greenwood

Map No. *Kans* Sec. *15* Twp. *22* R. *12*


Well No. *1 Boles* Farm
Prairie & Bellier Company

..... Ft. from N. Line

930 Ft. from S. Line

930 Ft. from E. Line

..... Ft. from W. Line

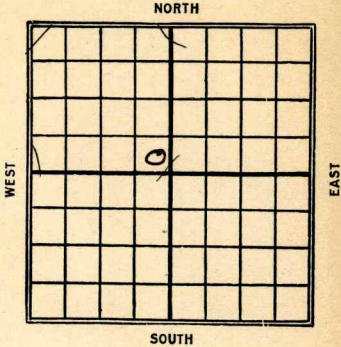

1926

Date	REPORT
<i>9/22</i>	<i>Location</i>
<i>9/29</i>	<i>same</i>
<i>10/13</i>	<i>machine</i>
<i>10/27</i>	<i>same</i>
<i>11/11</i>	<i>Drlg 360</i>
<i>11/17</i>	<i>" 450'</i>
<i>11/23</i>	<i>" 850'</i>
<i>12/8</i>	<i>" 1450</i>
<i>12/15</i>	<i>Broken sand 1740'-1786'</i> <i>show oil at 1786'-1803' S.D.</i>
<i>12/22</i>	<i>shot 50 gts, making</i> <i>10 bbls oil + 10 bbls water</i>
<i>12/30</i>	<i>will drill deeper</i>
<i>1927</i>	
<i>1/6</i>	<i>Shut down</i>
<i>1/13</i>	<i>Top lime 1862 Drlg</i>
<i>1/19</i>	<i>Bkn Sand 1740-86</i>
	<i>Show oil 1786-1803</i>
	<i>Top lime 1862</i>
	<i>S. & a. 1885</i>

Sherwood

21 KANSAS

Map No. _____ Sec. *15* Twp. *22* R. *12*

Well No. *1 Boles*
Praine & Belliere Company

Contractor _____

COMPLETED

SECTION PLAT

_____ Ft. from N. Line

330


_____ Ft. from S. Line

330

_____ Ft. from E. Line

_____ Ft. from W. Line

ABANDONED

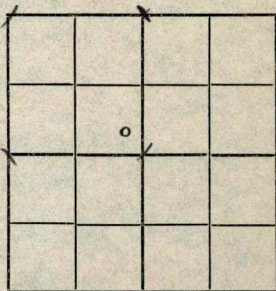

Location _____

Rig up _____

Drilling and Remarks:

Broken sd 1740-86

Show oil 1786-1803

+L 1862'

DDG 1885'

RECORD

Cased _____ in., _____ ft.

Sand _____

Gas _____

Oil _____

Total Depth *1885'*

PRODUCTION

1st 24 hrs. Nat. _____

1st 24 hrs. after shot _____

Gas _____ Cu. Ft.

Dry Hole

Abandoned

Date

JAN 19 1927

192

CHAS. L. SHERWOOD

Scout

Greenwood

21 **KANSAS** Map No. Sec. *15* Twp. *22* R. *12*


Well No. *1* *Doley* *Pratt & Belliere* Company

Contractor

FIRST REPORTS

SECTION PLAT

----- Ft. from N. Line
330 Ft. from S. Line
330 Ft. from E. Line
----- Ft. from W. Line

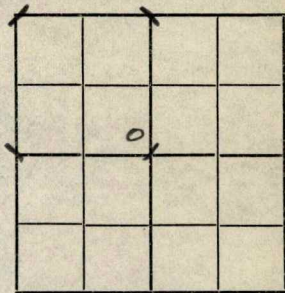

Location -----
Rig up -----
Drilling and Remarks:

RECORD

Cased ----- in., ----- ft.
Sand -----
Gas -----
Oil -----
Total Depth -----

PRODUCTION

1st 24 hrs. Nat. -----
1st 24 hrs. after shot -----
Gas ----- Cu. Ft.
Dry Hole -----
Abandoned -----

Date *SEP 22 1926*

SEP 22 1926 **CHAS. L. SHERWOOD** Scout