



Section 15 Township 22 Range 12E

Well No. #1 Boles

Company Jackman & Jackman
Miscellaneous

NORTH

⊙							

WEST

EAST

SOUTH

4

KANSAS

Greenwood



Sec. 15 Twp. 22 R. 12E

Well No. #1 Boles Farm

Jackman & Jackman Company

Miscellaneous


990' Ft. from N. Line

_____ Ft. from S. Line

_____ Ft. from E. Line

330' Ft. from W. Line

SW NW NW

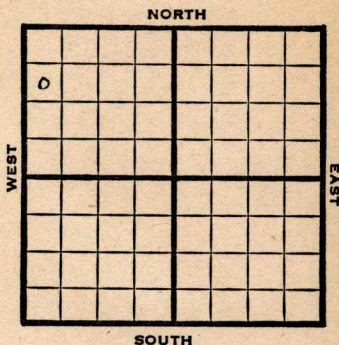

1948

Elev. -

REPORT

3/17 10" @ 85'
Drlg. 928'

3/24 TD 1791'

3/31 **Bart. 1762'**
TD 1791'

ABANDONED

Map No. 21 Sec. 15 Twp. 22 R. 12E

Well No. 1 Boles

Jackman & Jackman Company

ABANDONED

Contractor

SW NW NW

SECTION PLAT

o			

990 Ft. from N. Line

 Ft. from S. Line

 Ft. from E. Line

330 Ft. from W. Line

Greenwood County

Location

Rig up

Drilling and Remarks:

Bar #1762.

RECORD

Cased in., ft.

Sand

Gas

Oil

Total Depth 1791

PRODUCTION

1st 24 hrs. Nat.

1st 24 hrs. after shot

Gas Cu. Ft.

Dry Hole

Abandoned

Date

MAR 31 1948 19

S. J. LEWIS Scout

Map No. _____ Sec. 15 Twp. 22 R. 12E

Well No. 1 Boles

Jackman & Jackman Company

FIRST REPORT Contractor

SW NW NW

SECTION PLAT

990 Ft. from N. Line

_____ Ft. from S. Line

_____ Ft. from E. Line

330 Ft. from W. Line

o			

Greenwood County

Location _____

Rig up _____

Drilling and Remarks:

10" @ 85

drlg. 928

RECORD

Cased _____ in., _____ ft.

Sand _____

Gas _____

Oil _____

Total Depth _____

PRODUCTION

1st 24 hrs. Nat. _____

1st 24 hrs. after shot _____

Gas _____ Cu. Ft.

Dry Hole _____

Abandoned _____

Date

MAR 17 1948 19

S. J. LEWIS Scout