

Map No. _____ Sec. 15 Twp. 22 R. 4


Well No. 2 Burton Farm
Perse & Pierce Company

_____ Ft. from N. Line

1120 Ft. from S. Line

_____ Ft. from E. Line

660 Ft. from W. Line

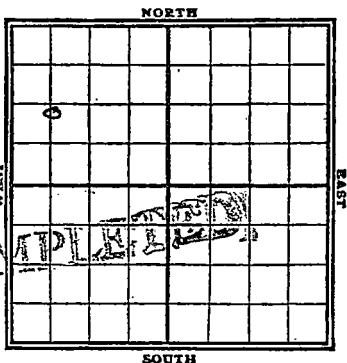

Date	REPORT FIRST REPORT
7/2	Log
9	Drilling
9	Rig
16	-
21	Rig
31	Spudding
8	Dlg 300
15	✓ 500
22	- 875
29	✓ 1175
4/12	✓ 1820
24	✓ 2200
30	8" 2355
5/3	Swedging 8" 2355
10	2365
22	6" - 2446
25	p.d. 2585
31	plug back to 2546
6/7	2543-46 15 Hlb.

Map No. K23 Sec. 15 Twp. 22 R. 4

Well No. 2 Burton

Pierce & Pierce Company

Contractor

SECTION PLAT

----- Ft. from N. Line

1120 Ft. from S. Line

----- Ft. from E. Line

660 Ft. from W. Line

o			
FIRST REPORT			

Location -----

Rig up -----

Drilling and Remarks:

J. O. I

RECORD

Cased ----- in., ----- ft.

Sand -----

Gas -----

Oil -----

Total Depth -----

PRODUCTION

1st 24 hrs. Nat. -----

1st 24 hrs. after shot -----

Gas ----- Cu. Ft.

Dry Hole -----

Abandoned -----

Date

2/2 1920

Pyle

Scout

Map No. K23 Sec. 15 Twp. 22 R. 4

Well No. 2 Burton
Pierce & Pierce Company

Contractor

SECTION PLAT

⊙			

COMPLETED

_____ Ft. from N. Line

1120 Ft. from S. Line

_____ Ft. from E. Line

660 Ft. from W. Line

Location _____

Rig up _____

Drilling and Remarks:

RECORD

Cased _____ in., _____ ft.

Sand 2543-46

Gas _____

Oil _____

Total Depth 2585

PRODUCTION

1st 24 hrs. Nat. 15 bbls

1st 24 hrs. after shot _____

Gas _____ Cu. Ft.

Dry Hole _____

Abandoned _____

Date

6/7 1920

Pyle

Scout