

Map No. _____ Sec. 15 Twp. 22 R. 4


Well No. 9 Burton Farm
Orlando Pet. Company

_____ Ft. from N. Line

1120 Ft. from S. Line

1120 Ft. from E. Line

_____ Ft. from W. Line

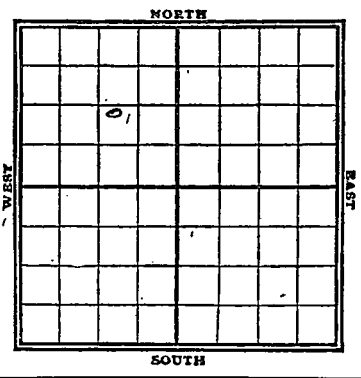

1940 Date	REPORT	
4/19	Rig up.	FIRST REPORT
7/6	✓	
2/2	✓	
9	Rig up.	
16	Tools	
21	Spud	
3/1	Drilg. 500'	
8	✓ 800	
15	10" - 1400	
22	Drilg 1970'	
29	✓ 2160'	
4/12	Csg parted 2400	
24	SD 2400	
30	SD ✓	
5/3	Sand 2547-50	450 lbs.

COMPLETED

Map No. K23 Sec. 15 Twp. 22 R. 4

Well No. 9 Burton
Orlando Pet Company

Contractor

SECTION PLAT

	0		

FIRST REPORT

----- Ft. from N. Line

1120 Ft. from S. Line

1120 Ft. from E. Line

----- Ft. from W. Line

CHANCE LOGGEE NAME

RECORD

Location -----

Rig up -----

Drilling and Remarks:

Cased ----- in., ----- ft.

Sand -----

Gas -----

Oil -----

Total Depth -----

PRODUCTION

1st 24 hrs. Nat. -----

1st 24 hrs. after shot -----

Gas ----- Cu. Ft.

Dry Hole -----

Abandoned -----

Date

Pyle

1/19 1910

Scout

Map No. K23 Sec. 15 Twp. 22 R. 4

Well No. 9 Burton
Orlando Oil Company

Contractor _____

SECTION PLAT

_____ Ft. from N. Line

1120 Ft. from S. Line

1120 Ft. from E. Line

_____ Ft. from W. Line

COMPLETED

Location _____

Rig up _____

Drilling and Remarks:

RECORD

Cased _____ in., _____ ft.

Sand 2547-50

Gas _____

Oil _____

Total Depth _____

PRODUCTION

1st 24 hrs. Nat. 450 bbls

1st 24 hrs. after shot _____

Gas _____ Cu. Ft.

Dry Hole _____

Abandoned _____

Date

5/3 191 _____

Pyle

Scout