

Map No. _____ Sec. 15 Twp. 22R 11E

Well No. 4 Farm _____


Empire Gas & F Company

330 Ft. from N. Line

_____ Ft. from S. Line

330 Ft. from E. Line

_____ Ft. from W. Line

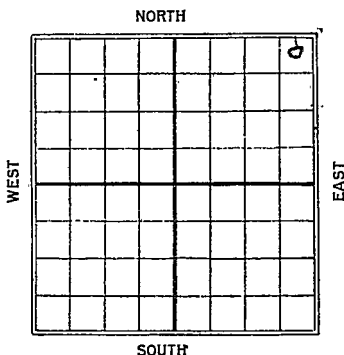

Date	REPORT
1925	
4/10	Key up
5/21	Top sand 1827
	Oil 1839-1878
	80 gts 45 Bbls

Map No. 14th Sec. 15 Twp. 22 R. 11 E

Well No. 4 Dees
Empire Dr & Fuel Co Company

Contractor

FIRST REPORTS

SECTION PLAT

330 Ft. from N. Line

_____ Ft. from S. Line

330 Ft. from E. Line

_____ Ft. from W. Line

			0

Location

Rig up

Drilling and Remarks:

RECORD

Cased _____ in., _____ ft.

Sand _____

Gas _____

Oil _____

Total Depth _____

PRODUCTION

1st 24 hrs. Nat. _____

1st 24 hrs. after shot _____

Gas _____ Cu. Ft.

Dry Hole _____

Abandoned _____

Date

APR 10 1925

192

Chas. L. Sherwood Scout

Map No. 1722 Sec. 15 Twp. 22 R. 11

Well No. H Free

Empire Oil & Fuel Co. Company

Contractor

COMPLETED

SECTION PLAT

330 Ft. from N. Line
 _____ Ft. from S. Line
330 Ft. from E. Line
 _____ Ft. from W. Line

			0

Location _____

Rig up _____

Drilling and Remarks:
Top of 1827' ist
oil 1839-1878'

807 45 b/s.

RECORD

Cased _____ in., _____ ft.
 Sand _____
 Gas _____
 Oil _____
 Total Depth 1878

PRODUCTION

1st 24 hrs. Nat. _____
 1st 24 hrs. after shot _____
 Gas _____ Cu. Ft.
 Dry Hole _____
 Abandoned _____

Date

MAY 21 1925

CHAS. L. SHERWOOD

Scout