


Marion

Section 16 Township 22 Range 4E **KANSAS**

Well No. #1 Jolfe (Jolliffe)

Company Geo. Hoisington

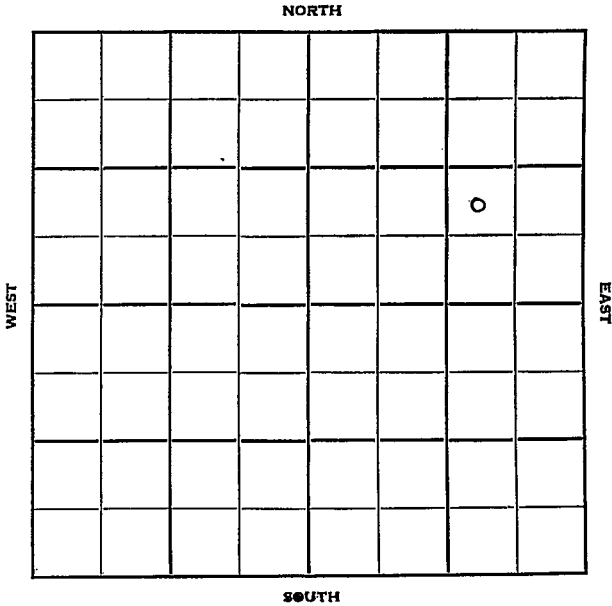

8

Marion

KANSAS

Sec. 16 Twp. 22 R. 4 E

Well No. # 1 Jolffe Farm

Geo. Hoisington Company

Mendenhall Contractor


Ft. from N. Line

990 Ft. from S. Line

990 Ft. from E. Line

Ft. from W. Line

NW SE NE

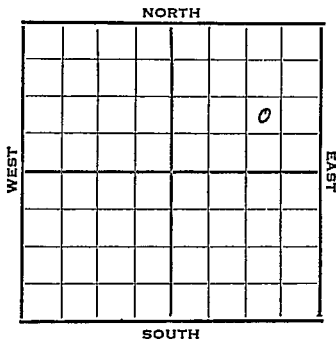

1951

Elev. - REPORT

11/28

RUR

12/19

Spud 11-29-51  
 D & A TD 2676'  
 8" @ 92 Lans. 1881'  
 Miss chat 2384' Miss lime 2403'  
 Kh. 2448' Misener 2525'  
 Hunton 2558' Simp. dol. 2642'  
 Simp. sd. 2671'  
 TD 2676' D & A

ABANDONED

County Marion State Kansas

Sec. 16 (Blk.) 22 (Sur.) 4E Map No.

Operator Geo. Hoisington

Well No. 1 Farm Jolffe

Elev. \_\_\_\_\_ Location NW SE NE


990 Ft. From S Line NE

990 Ft. From E Line Quarter

Ist. Report NOV 26 1951

Completion \_\_\_\_\_

Remarks \_\_\_\_\_

Spudding Date \_\_\_\_\_

Drlg. Data \_\_\_\_\_

RUR

**J. E. TYRA**

