



Map No. Kansas Sec. 16 Twp. 22 R. 5

Well No. 1 Jensen Farm


Phillips Pet Co. Company

1020 Ft. from N. Line

\_\_\_\_\_ Ft. from S. Line

300 Ft. from E. Line

\_\_\_\_\_ Ft. from W. Line

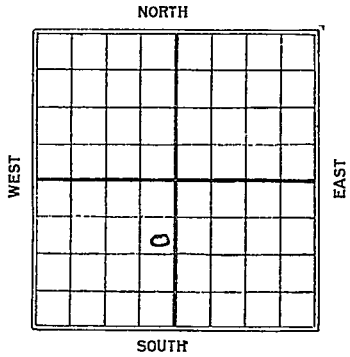

S

Date	REPORT
1925	
<del>6/15</del> 6/15	Bly Recg
6/12	Rig
6/19	Rig w/ up
6/26	500
7/3	1350
7/10	1725
7/17	2125
7/24	Chat 2359-85-S.D.
7/31	2440'
8/7	<del>Chart</del> Chat 2359-85
	N.F.W. - L0 + A 2702

Map No. 28 1/2 Sec. 16 Twp. 22 R. 5

Well No. 1 Gordon  
Phillips & Co Company

Contractor

FIRST REPORTS

SECTION PLAT

1070 Ft. from N. Line

Ft. from S. Line

300 Ft. from E. Line

Ft. from W. Line

		6	

Location

Rig up

Drilling and Remarks:

Blky Rey

RECORD

Cased \_\_\_\_\_ in., \_\_\_\_\_ ft.

Sand \_\_\_\_\_

Gas \_\_\_\_\_

Oil \_\_\_\_\_

Total Depth \_\_\_\_\_

PRODUCTION

1st 24 hrs. Nat. \_\_\_\_\_

1st 24 hrs. after shot \_\_\_\_\_

Gas \_\_\_\_\_ Cu. Ft.

Dry Hole \_\_\_\_\_

Abandoned \_\_\_\_\_

Date

JUN 5. 1925

CHAS. L. SHERWOOD  
 Scout

Map No. 23 Sec. 16 Twp. 22 R. 5

Well No. 1 Jenson

Phillips Pet Co Company

Contractor

COMPLETED

SECTION PLAT

1080 Ft. from N. Line

Ft. from S. Line

300 Ft. from E. Line

Ft. from W. Line

		0	

ABANDONED

Location

Rig up

Drilling and Remarks:

CHT v359 85' HFV

Dry 2 hrs

L.D. v702'

RECORD

Cased \_\_\_\_\_ in., \_\_\_\_\_ ft.

Sand \_\_\_\_\_

Gas \_\_\_\_\_

Oil \_\_\_\_\_

Total Depth 2702'

PRODUCTION

1st 24 hrs. Nat. \_\_\_\_\_

1st 24 hrs. after shot \_\_\_\_\_

Gas \_\_\_\_\_ Cu. Ft.

Dry Hole

Abandoned

Date

AUG 7 1925

CHAS. L. SHERWOOD  
Scout