
Form 51 5M 7-22 9573

Map No. 9 Sec. 16 Twp. 22 R. 12

Well No. 1 Smithson Farm

Tanner Oil Company

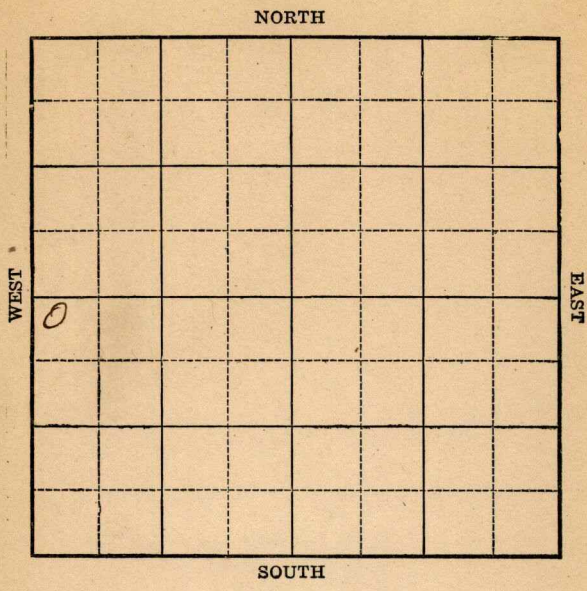

Location _____

Drilling Remarks:

Rig up _____

Drilling Remarks:

RECORD

Cased _____ in. _____ ft.

Sand _____

Gas _____

Oil _____

Total Depth _____

PRODUCTION

1st 24 hrs Nat. _____

1st 24 hrs. after shot _____

Gas _____ cu. ft.

Dry Hole _____

Abandoned _____

Form 252A 5M 8-21 PALACE-TULSA 6835

Map No. _____ Sec. 16 Twp. 22 R. 12

Well No. 1 Smithurn Farm


Tanner Oil Company

200 Ft. from N, Line

_____ Ft. from S. Line

_____ Ft. from E. Line

200 Ft. from W. Line

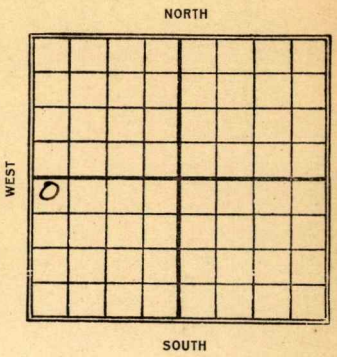

Date 1923	REPORT
1/12	D. & C. 2450'

Form 26—1M—4-19—Mid-West

Map No. KANSAS 21 Sec. 16 Twp. 22 R. 12

Well No. 1 Smithson

Farmers Oil — Company

Contractor

ABANDONED

FIRST REPORT


SECTION PLAT

200 Ft. from N. Line

Ft. from S. Line

Ft. from E. Line

200 Ft. from W. Line

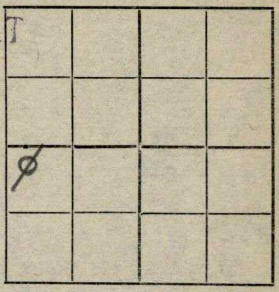

Location

Rig up

Drilling and Remarks:

L.+A. 2450'.

78' ft. in 2nd

Sand.

RECORD

Cased in., ft.

Sand

Gas

Oil

Total Depth

PRODUCTION

1st 24 hrs. Nat.

1st 24 hrs. after shot

Gas Cu. Ft.

Dry Hole

Abandoned

Date

JAN 12 1923 191

M. A. BENEAR Scout