


Greenwood

Form 51-5M-5-34-Palace

Map No. **KANSAS** Sec. 16 Twp. 22 R. 12E

Well No. #1 Schvab Farm  
Henderson & Holden Company

NORTH

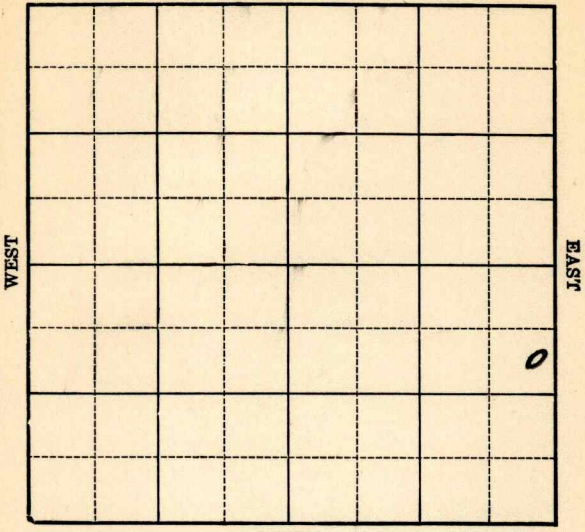

SOUTH

Location \_\_\_\_\_

Drilling Remarks \_\_\_\_\_

\_\_\_\_\_

\_\_\_\_\_

Rig Up \_\_\_\_\_

Drilling Remarks \_\_\_\_\_

\_\_\_\_\_

\_\_\_\_\_

**RECORD**

Cased \_\_\_\_\_ in. \_\_\_\_\_ ft.

Sand \_\_\_\_\_

Gas \_\_\_\_\_

Oil \_\_\_\_\_

Total Depth \_\_\_\_\_

**PRODUCTION**

1st 24 hrs. Nat. \_\_\_\_\_

1st 24 hrs. after shot \_\_\_\_\_

Gas \_\_\_\_\_ cu. ft.

Dry Hole \_\_\_\_\_

Abandoned \_\_\_\_\_

*Greenwood*

Map No. KANSAS Sec. 16 Twp. 22 R. 12E

Well No. #1 Schwab Farm  
Henderson & Holden Company


NORTH

990 Ft. from N. Line

\_\_\_\_\_ Ft. from S. Line

250 Ft. from E. Line

\_\_\_\_\_ Ft. from W. Line

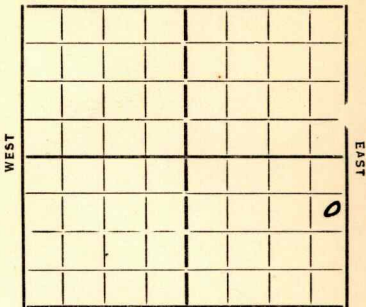

SOUTH

Date

REPORT

1935  
2/3 dy 460  
2/21 " 720  
2/28 " 1125  
3/7 Sand 1765-85 line 1837  
dy 1856  
3/13 Line 1837 to 1872 70 ft.

**ABANDONED**

Map No. *21* Sec. *16* Twp. *22* R. *12E*

Well No. *1-Schwat*

*Henderson & Holden* Company

Contractor

**FIRST REPORTS**

**SECTION PLAT**

**KANSAS**

*990* Ft. from N. Line

..... Ft. from S. Line

*250* Ft. from E. Line

..... Ft. from W. Line

			<i>0</i>

Location .....

Rig up .....

Drilling and Remarks:

*Well 460*

**RECORD**

Cased.....in., .....ft.

Sand.....

Gas.....

Oil.....

Total Depth.....

**PRODUCTION**

1st 24 hrs. Nat.....

1st 24 hrs. after shot.....

Gas.....Cu. Ft.

Dry Hole.....

Abandoned.....

Date

*2-13-35* 192.....

**ORVAL MANNSCHRECK**

Scout

Map No. 21 Sec. 16 Twp. 22 R. 12E

Well No. 1-Schwab  
Henderson + Holden Company

Contractor

ABANDONED

SECTION PLAT

990 Ft. from N. Line

..... Ft. from S. Line

250 Ft. from E. Line

..... Ft. from W. Line

			0

Location.....

Rig up.....

Drilling and Remarks:

RECORD

Cased..... in.,..... ft.

Sand lime 1837

Gas.....

Oil.....

Total Depth 1872

PRODUCTION

1st 24 hrs. Nat.....

1st 24 hrs. after shot.....

Gas..... Cu. Ft.

Dry Hole.....

Abandoned.....

Date

3-13-35 192.....

ORVAL MANNSCHRECK

Scout

W + A