

KANSAS


Harvey

Section 17 Township 22 Range 2EWell No. 3 HessCompany C.F. Meyer et al

Wildcat

NORTH

WEST

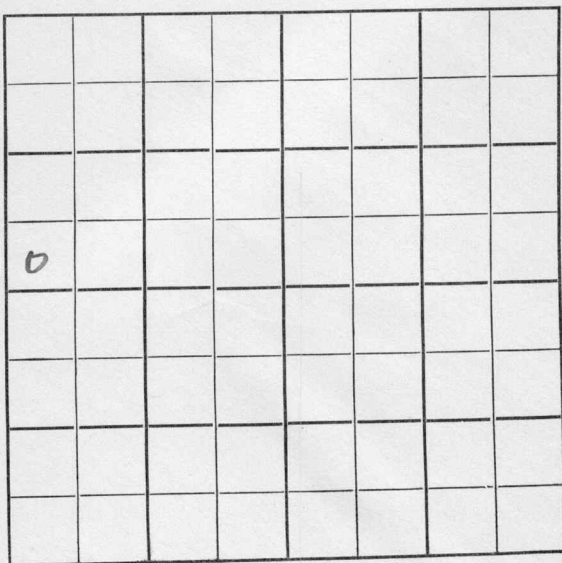

EAST

SOUTH

Harvey

KANSAS ✓

Sec. 17 Twp. 22 R. 2E

Well No. #3 Hess Farm

C. F. Meyer et al Company

Wildcat

 Ft. from N. Line

330'


 Ft. from S. Line

 Ft. from E. Line

330'

 Ft. from W. Line

SW. NW

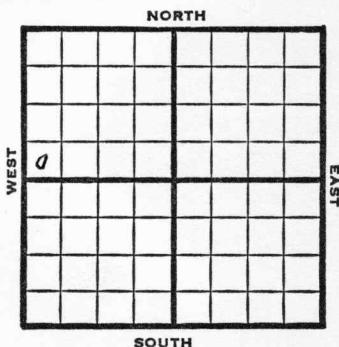

1949

Elev 1549'

REPORT

10/19

Location

10/26

"

11/2

"

11/9

RUR

11/16

8"@ 65'

Drlg 2323'

11/23

Drlg. 3170'

11/29

TD 3545'

12/7

TD 3545'

Arb. 3485'


Aband.

ABANDONED

Kansas

Map No. _____ Sec. 17 Twp. 22 R. 2EWell No. 3 HessC. F. Meyer et al. CompanyAllison Contractor

SW NW

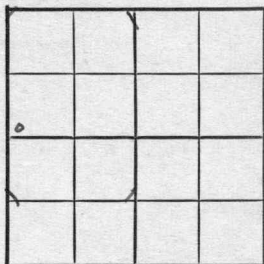FIRST REPORT
SECTION PLAT

_____ Ft. from N. Line

330 Ft. from S. Line

_____ Ft. from E. Line

330 Ft. from W. LineHarvey CountyLocation X

Rig up _____

Drilling and Remarks:

RECORD

Cased _____ in., _____ ft.

Sand _____

Gas _____

Oil _____

Total Depth _____

PRODUCTION

1st 24 hrs. Nat. _____

1st 24 hrs. after shot _____

Gas _____ Cu. Ft.

Dry Hole _____

Abandoned _____

Date

OCT 19 1949

19

S. J. LEWIS Scout

Kansas

Map No. _____ Sec. 17 Twp. 22 R. 2EWell No. 3 Hess

C. F. Meyer et al. _____ Company

ABANDONED

Contractor

SW NW


E1.1549

SECTION PLAT

_____ Ft. from N. Line

330 Ft. from S. Line

_____ Ft. from E. Line

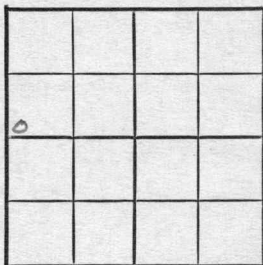330 Ft. from W. Line

Harvey County

Location _____

Rig up _____

Drilling and Remarks:

Cut 3485'

RECORD

Cased _____ in., _____ ft.

Sand _____

Gas _____

Oil _____

Total Depth 3545

PRODUCTION

1st 24 hrs. Nat. _____

1st 24 hrs. after shot _____

Gas _____ Cu. Ft.

Dry Hole _____

Abandoned _____

Date

DEC 7 1949 19

S. J. LEWIS Scout