

Map No. \_\_\_\_\_ Sec. 17 Twp. 22 R. 12

Well No. *1 Thresher* Farm

Well No. 1755 Farm Unknown  
Company

NORTH

WEST

EAST

SOUTH

Location \_\_\_\_\_

Drilling Remarks:

Rig up \_\_\_\_\_

Drilling Remarks:

# RECORD

Cased \_\_\_\_\_ in. \_\_\_\_\_ ft.

Sand \_\_\_\_\_

Gas \_\_\_\_\_

Oil \_\_\_\_\_

Total Depth\_\_\_\_\_

## PRODUCTION

1st 24 hrs Nat. \_\_\_\_\_

1st 24 hrs. after shot\_\_\_\_\_

Gas \_\_\_\_\_ cu. ft.

**Dry Hole**\_\_\_\_\_

Abandoned \_\_\_\_\_

Map No. \_\_\_\_\_ Sec. 17 Twp. 22 R. 12

Well No. 1 Kipsen Farm  
Unknown Company


NORTH

Ft. from N, Line

200 Ft. from S. Line

1120 Ft. from E. Line

Ft. from W. Line

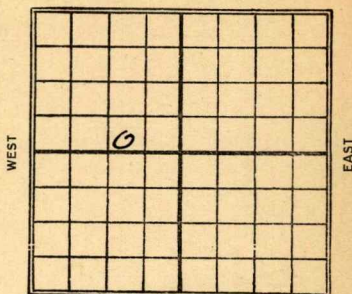

**SOUTH**

Date  
1923

## REPORT

1/12	D. & A. 1935
------	--------------



Map No. <sup>21</sup>~~KANSAS~~ Sec. <sup>17</sup> Twp. <sup>22</sup> R. <sup>12</sup>

Well No. <sup>1 Kipper</sup>  
<sup>Unknown</sup> Company

Contractor

# ABANDONED

## SECTION PLAT

### FIRST REPORT

Ft. from N. Line

<sup>200</sup> Ft. from S. Line

<sup>1120</sup> Ft. from E. Line

Ft. from W. Line


### RECORD

Location

Rig up

Drilling and Remarks:

Cased in, ft.

Sand

Gas

Oil

Total Depth

### PRODUCTION

1st 24 hrs. Nat.

1st 24 hrs. after shot

Gas Cu. Ft.

Dry Hole

Abandoned <sup>1935</sup>

Date

M. A. BENEAR

JAN 12 1933

191

Scout